

MISSISSIPPI
BOARD OF WATER COMMISSIONERS
416 North State Street
Jackson, Mississippi 39201

CODED

WATER WELL DRILLERS LOG

WALTHALL
K-5
7-18-71

7-18 1971 B. Woodward Drilling Walthall
date well completed firm name county well located

LANDOWNER: J. W. McBeth

description of formations encountered

from to

	clay		30'
Zylertown	sand and gravel	30	65'
(mailing address)	clay	65	

WELL LOCATION:

sec. 34 T 1 N R 12 E
6 miles South of Depton
(distance) (direction) (nearest town)

WELL PURPOSE: Home
(home, irrigation, municipal, industrial)

WELL COMPLETION DATA:

- diameter (inches) 4
- total depth (feet) 65
- static water level (feet) 40 below top of ground.
- casing Plastic 55'
(material) (depth)
4" If telescope see back.
(size)
- screen 10' 55'
(length) (depth to top)
4" Plastic
(size) (material)
- pump 1/2 11
(HP) (yield gpm)
115V AC
(type power)
- electric log ND
(yes or no)

CODED

AUG 3 - 1971


(organization running log)

(8) how well bottom plugged float
Type Beckman Valve

DRILLERS REMARKS:

If well telescopes please sketch and show depths.

GROUND LEVEL

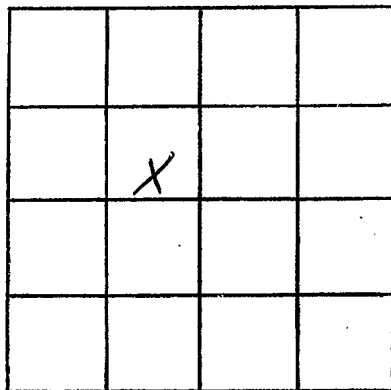

SECTION 34

Please indicate well location X.

ADDITIONAL INFORMATION

If more than one screen,
show locations of each on sketch.