

Waithall

K7

8-66

CODED

MISSISSIPPI BOARD OF WATER COMMISSIONERS

WATER WELL DRILLERS LOG

Date: 8-24, 1966, Driller: W J Fitzgerald County: Waithall

(When well drilled)

(Name)

(Where well is located)

(1) Owner of Land: Reed Herring
(Name)
Tylertown
(Address)
(2) Location: NE 1/4 NW 1/4, Sec. 11 T. 1 R. 12
10 miles SE of Tylertown
(distance) (direction) (Nearest Town)
(3) Topography: Hilly
(Hilly) (Flat) (Level)
(4) Purpose of Well: Domestic
(Domestic Irrigation
Municipal, Industrial, Other)


Description & Color of Materials Sand, Clay, Red Clay, Shell, etc.	Thick- ness Feet	Depth Feet
Topsoil / Clay	20	20
Red Sand	38	58
Gravel / Sand	22	80
Heavy gravel	38	118
Red clay	32	150
White sand / gravel	20	170

Information upon completion of well:

(1) Diameter: 4 inches.
(2) Total Depth: 168 feet.
(3) Water Level: 110 feet below top of ground.
(4) Cased to: 160, Size: 4
(5) Screen: Size: 4, Length: 8'
(6) Were any formations sealed against pollution?
yes, no.

CODED

If YES depth of formation _____
Why _____
Drillers Remarks: _____
Yield in gpm: _____
Size pump: 1 HP
Type power: electric

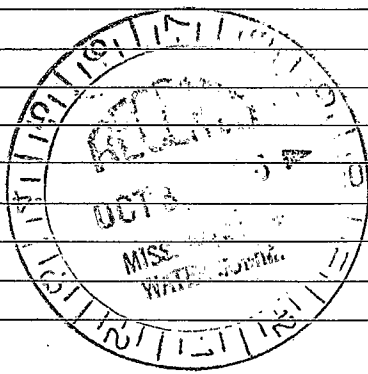

Mail this copy to Board of Water Commissioners 429 Miss. St. Jackson, Miss.

