

Walthall

K 8

9-66

MISSISSIPPI BOARD OF WATER COMMISSIONERS

CODED

WATER WELL DRILLERS LOG

Date: 9-10, 1966, Driller: Vic Fitzgerald, County: Walthall

(When well drilled)

(Name)

(Where well is located)

(1) Owner of Land: Dexter High School
(Name)
Superior
(Address)

(2) Location: NE 1/4, NE 1/4, Sec. 9 (21)
10 miles SE of Superior
(distance) (direction) (Nearest Town)

(3) Topography: Hilly
(Hilly) (Flat) (Level)

(4) Purpose of Well: Domestic
(Domestic Irrigation, Municipal, Industrial, Other)

Description & Color of Materials Sand, Clay, Red Clay, Shell, etc.	Thick- ness Feet	Depth Feet
top 30' red clay	30	30
Red sand	30	60
Red sandy loam	20	80
Sand & gravel	19	99
Sand & Chalk + Pebbles	22	121
Gravel & coarse sand	7	128
Chalk - White	128	

Information upon completion of well:

(1) Diameter: 4 inches.

(2) Total Depth: 128 feet.

(3) Water Level: 65 feet below top of ground.

(4) Cased to: 120, Size 4"

(5) Screen: Size 4, Length 8'

(6) Were any formations sealed against pollution?
yes, no.

CODED

YES depth of formation _____


Why _____

Drillers Remarks: _____

Yield in gpm: 25

Size pump: HP Sub-

Type power: Elec

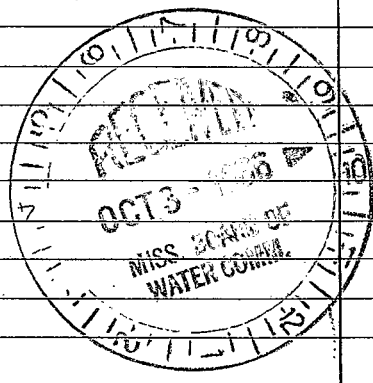

Mail this copy to Board of Water Commissioners 429 Miss. St. Jackson, Miss.

... ..

... ..

