

Walthall  
K 9  
1-67 CODED

MISSISSIPPI  
BOARD OF WATER COMMISSIONERS  
416 North State Street  
Jackson, Mississippi 39201

WATER WELL DRILLERS LOG

Jan. 21 1967 Andie's Drilling Co. Walthall  
date well completed firm name county well located

LANDOWNER: L. C. McCullen  
P.O. 1 Sandy Hook  
Miss.  
(mailing address)


description of formations encountered	from	to
<u>Red Clay</u>	<u>0'</u>	<u>40'</u>
<u>Red Sandy Clay</u>	<u>40'</u>	<u>100'</u>
<u>Coarse Sand / pea gravel</u>	<u>100'</u>	<u>120'</u>

WELL LOCATION:  
sec. 2 T. 1 N. R. 12 E  
2 miles E of Dextee  
(distance) (direction) (nearest town)

WELL PURPOSE: Home  
(home, irrigation, municipal, industrial)

- WELL COMPLETION DATA:
- (1) diameter (inches) 4"
  - (2) total depth (feet) 120'
  - (3) static water level (feet) 100' below top of ground.
  - (4) casing Plastic 1 1/4" (material), (depth)
  - 4" (size) if telescope see back.
  - (5) screen 6" (length), 1 1/4" (depth to top)
  - 4" (size), Plastic (material)
  - (6) pump 10 (yield gpm)
  - (type power)
  - (7) electric log no (yes or no)
  - (organization running log)
  - (8) how well bottom plugged Back Wash Valve

DRILLERS REMARKS:  
BUCKET Well

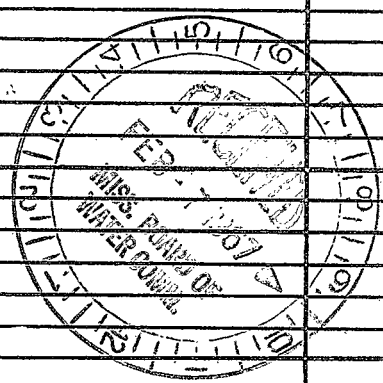

CODED

