

Walthall
K 10
4-67

MISSISSIPPI
BOARD OF WATER COMMISSIONERS
416 North State Street
Jackson, Mississippi 39201

WATER WELL DRILLERS LOG

4/1 19 67 And's Drilling Walthall
date well completed firm name county well located

LANDOWNER: R. S. Heasley

description of formations encountered

from to

Rt. 1 Box 79 C
Sandy Hook, Miss.
(mailing address)

Red Clay 0' 4'

Gravel 40' 60'

Chalk 60' 80'

Sand 80' 100'

Coarse sand / gravel 100' 140'

WELL LOCATION:

sec. 7 T. 1 N. R. 12 E. S. 5 W.
4 1/2 miles S. W. of Dexter
(distance) (direction) (nearest town)

WELL PURPOSE: Home
(home, irrigation, municipal, industrial)

WELL COMPLETION DATA:


- (1) diameter (inches) 4"
- (2) total depth (feet) 140'
- (3) static water level (feet) 70 below top of ground.
- (4) casing P.V.C. 134' (material) (depth)
4" (size) if telescope see back.
- (5) screen 6' 134' (length) (depth to top)
4" (size) P.V.C. (material)
- (6) pump 1 12 (HP) (yield gpm)
220 (type power)
- (7) electric log No (yes or no)

CODED

(organization running log)


(8) how well bottom plugged Back
Wash down

DRILLERS REMARKS:

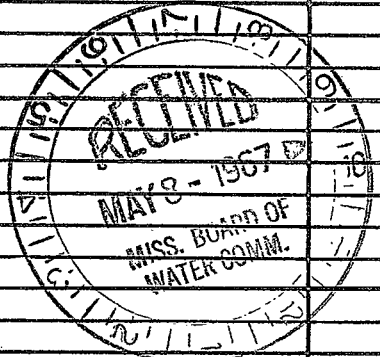

If well telescopes please sketch and show depths.

GROUND LEVEL

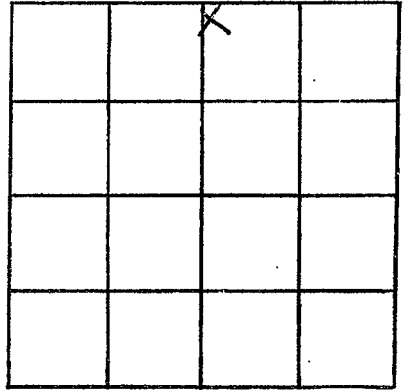

SECTION 7

Please indicate well location X.

ADDITIONAL INFORMATION

If more than one screen,
show locations of each on sketch.