

CODED

MISSISSIPPI
BOARD OF WATER COMMISSIONERS
416 North State Street
Jackson, Mississippi 39201

WATER WELL DRILLERS LOG

Wathall
K 13
6-18-69

June 18 1969 Mc Schais Water Well Service Wathall
date well completed firm name county well located

LANDOWNER: Pete Carbern
Tylertown, Miss.

description of formations encountered	depth	
	from	to
Clay	0'	20'
7" ind sand	20'	90'
Clay	90'	100'
7" ind sand	100'	110'
Course sand	110'	126'
Course sand - Peas sand	126'	152'

(mailing address)

WELL LOCATION:

sec 8 T 1 N R 12 E
1 1/2 miles SSW of Tylertown
(distance) (direction) (nearest town)

WELL PURPOSE: home
(home, irrigation, municipal, industrial)

WELL COMPLETION DATA:

- (1) diameter (inches) 4"
- (2) total depth (feet) 152'
- (3) static water level (feet) 80' below top of ground.
- (4) casing PVC, 152' (material) (depth)
- (size) If telescope see back.
- (5) screen 5' (length) (depth to top)
- 4" PVC (size) (material)
- (6) pump 1/2 HP, 800 GPH. (HP) (yield gpm)
- Electric (type power)
- (7) electric log NO (yes or no)

(organization running log)

(8) how well bottom plugged Back Pressure Valve


DRILLERS REMARKS:

JUL 3 - 1969

MISS. RD. OF
WATER COMM.

If well telescopes please sketch and show depths.

GROUND LEVEL

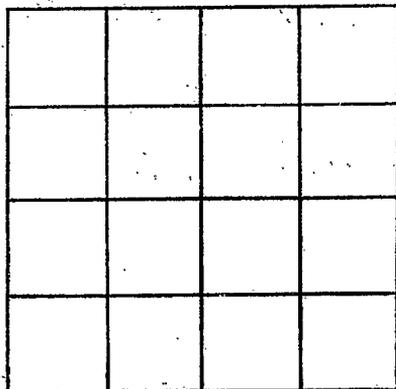

SECTION _____

Please indicate well location X.

ADDITIONAL INFORMATION

If more than one screen, show locations of each on sketch.