

Walthall Co

MISSISSIPPI  
BOARD OF WATER COMMISSIONERS  
416 North State Street  
Jackson, Mississippi 39201

CODED

WATER WELL DRILLERS LOG

~~July 7~~ July 7 1968 ~~Esley Stafford~~ Esley Stafford  
date well completed firm name county well located

LANDOWNER:

Marage Kennedy  
Rt 2, lands Hook, Miss.  
(mailing address)

description of formations encountered

from

to

Red Chalk 0' 40'  
Red sand 40' 60'  
Chalk 60' 141'  
Sand & Gravel 140' 169'

WELL LOCATION:

sec. 21 T 1 N R 12 E  
S W  
19 mi. miles E of Juba town  
(distance) (direction) (nearest town)

WELL PURPOSE: Home  
(home, irrigation, municipal, industrial)

WELL COMPLETION DATA:

- (1) diameter (inches) 4"
- (2) total depth (feet) 169 ft
- (3) static water level (feet) NO below top of ground.
- (4) casing Plastic, 159 ft  
(material) (depth)  
(size) if telescope see back.
- (5) screen 10 ft, 159 ft  
(length) (depth to top)  
4" Plastic  
(size) (material)
- (6) pump 3/4 600 hr.  
(HP) (yield gpm)  
ELE  
(type power)
- (7) electric log NO  
(yes or no)  
(organization running log)
- (8) how well bottom plugged BWV


DRILLERS REMARKS:

AUG 7 1968

MISS. Bd. of  
WATER COMM.

If well telescopes please sketch and show depths.

GROUND LEVEL

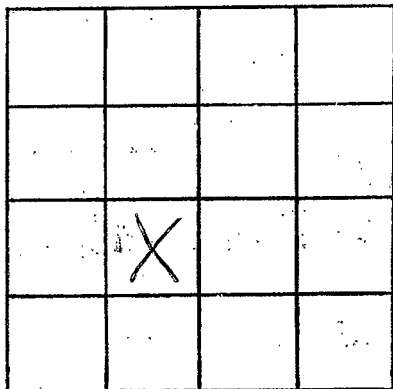

SECTION \_\_\_\_\_

Please indicate well location X.

ADDITIONAL INFORMATION

If more than one screen, show locations of each on sketch.