

CODED

MISSISSIPPI
BOARD OF WATER COMMISSIONERS
416 North State Street
Jackson, Mississippi 39201

WATER WELL DRILLERS LOG

Walshall
K 15
7-69

July 8 1969 R. Woodward Drilling WAITHAII
date well completed firm name county well located

LANDOWNER: <u>M. Nelson Steyer</u>	description of formations encountered	from	to
<u>Pt. 7</u>	<u>Red surface clay</u>		<u>4</u>
<u>Fylertown, Miss.</u> (mailing address)	<u>reddish sand</u>	<u>4</u>	<u>38</u>
WELL LOCATION: sec. <u>22</u> T <u>1</u> N R. <u>12</u> E <u>5</u> miles <u>S</u> of <u>Dexter</u> (distance) (direction) (nearest town)	<u>Clay</u>	<u>38</u>	<u>42</u>
	<u>sand and gravel</u>	<u>42</u>	<u>47</u>
WELL PURPOSE: <u>HOME</u> (home, irrigation, municipal, industrial)	<u>clay</u>	<u>47</u>	<u>99</u>
WELL COMPLETION DATA:	<u>sand and gravel</u>	<u>99</u>	<u>130</u>
(1) diameter (inches) <u>4</u>			
(2) total depth (feet) <u>130</u>			
(3) static water level (feet) <u>45</u> below above top of ground.			
(4) casing <u>PLASTIC</u> , <u>120'</u> (material) (depth)			
<u>4"</u> (size) if telescope see back.			
(5) screen <u>10'</u> , <u>120'</u> (length) (depth to top)			
<u>4"</u> , <u>PLASTIC</u> (size) (material)			
(6) pump <u>1</u> <u>7</u> (HP) (yield gpm)			
<u>ELECTRIC</u> (type power)			
(7) electric log <u>NO</u> (yes or no)			
(organization running log)			
(8) how well bottom plugged <u>FLOAT-</u> <u>TYPE BIER WASH VALVE</u>			


AUG 6 1969

MISS. Bd. OF
WATER COMMISSIONERS

DRILLERS REMARKS:

If well telescopes please sketch and show depths.

GROUND LEVEL

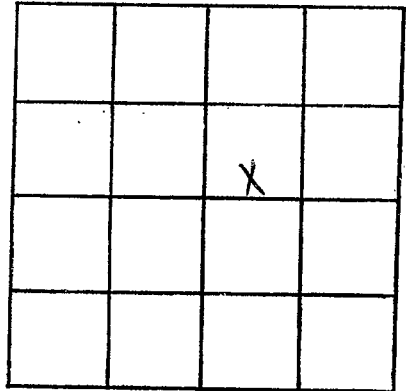

SECTION 22

Please indicate well location X.

ADDITIONAL INFORMATION

If more than one screen,
show locations of each on sketch.