

CODED

CODED

WALTHALL
K 16.
12-17-69

MISSISSIPPI  
 BOARD OF WATER COMMISSIONERS  
 416 North State Street  
 Jackson, Mississippi 39201

WATER WELL DRILLERS LOG

Dec 17, 1969 Essley Stafford Water Well Service  
 date well completed first name county well located  
Walthall

LANDOWNER: <u>Ervell Jenkins</u>	description of formations encountered	from	to
<u>Sandy Hook, Miss</u> (mailing address)	<u>Red Chalk</u>	<u>0</u>	<u>20</u>
WELL LOCATION: sec. <u>35</u> T <u>1</u> N R <u>12</u> E <u>7</u> miles <u>South</u> , <u>Dexter</u> (distance) (direction) (nearest town)	<u>Sand &amp; Gravel</u>	<u>20</u>	<u>160</u>
WELL PURPOSE: (home, irrigation, municipal, industrial)			
WELL COMPLETION DATA: (1) diameter (inches) <u>4 in</u> (2) total depth (feet) <u>160 ft</u> (3) static water level (feet) <u>137</u> below above top of ground. (4) casing <u>Plastic</u> , <u>160</u> (material) (depth) <u>4 in</u> if telescope see back. (size) (5) screen <u>10 ft</u> , <u>150</u> (length) (depth to top) <u>4 in</u> , <u>Plastic</u> (size) (material) (6) pump <u>3/4</u> <u>1500 gpm</u> (HP) (yield gpm) <u>Elec.</u> (type power) (7) electric log <u>No</u> (yes or no) (organization running log) (8) how well bottom plugged <u>B W V</u>			
DRILLERS REMARKS: <u>Charles Stafford</u>			


DEC 29 1969

MISS. RD. OF

W/A

If well telescopes please sketch and show depths.

GROUND LEVEL

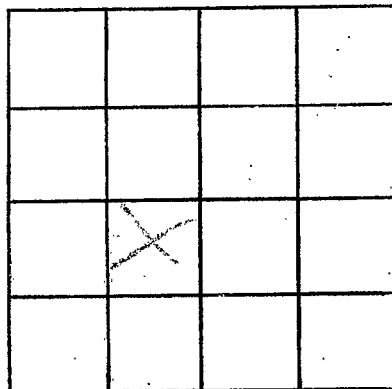

SECTION \_\_\_\_\_

Please indicate well location X.

ADDITIONAL INFORMATION

If more than one screen, show locations of each on sketch.