

Walshall  
 R 18  
 12-12-69

MISSISSIPPI  
 BOARD OF WATER COMMISSIONERS  
 416 North State Street  
 Jackson, Mississippi 39201

CODED  
 CODED

WATER WELL DRILLERS LOG

Dec 12 1969 Reverse Well Drilling Co Walshall  
 date well completed firm name county well located


LANDOWNER	description of formations encountered	from	to
Blackwell Rt. 7, Tylertown (mailing address)	Red clay Red Chalky sand	0	22
WELL LOCATION: sec. 19 T 1 N R 12 E 9 miles SE of Tylertown (distance) (direction) (nearest town)	Small gravel sand	22	82
WELL PURPOSE: Home (home, irrigation, municipal, industrial)			
WELL COMPLETION DATA:			
(1) diameter (inches) 4"			
(2) total depth (feet) 96			
(3) static water level (feet) 74 below top of ground			
(4) casing Plastic bottom (material) (depth)			
_____ if telescope see back.			
(5) screen 6' 90' (length) (depth to top)			
4" Plastic (size) (material)			
(6) pump 1/2 HP 191 (HP) (yield gpm)			
Electric (type power)			
(7) electric log No (yes or no)			
_____ (organization running log)			
(8) how well bottom plugged waddy plug			
DRILLERS REMARKS: New house			

MISS. Bd. of Water Comm.  
 JAN - 9 1970

MISS. Bd. of Water Comm.

If well telescopes please sketch and show depths.

GROUND LEVEL

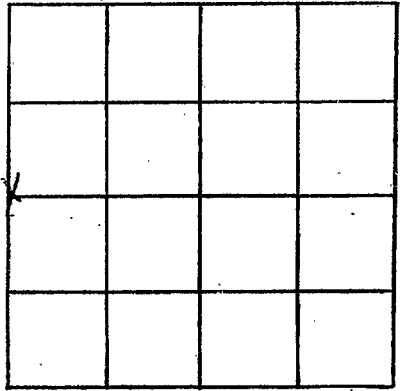

SECTION 19

Please indicate well location X.

ADDITIONAL INFORMATION

If more than one screen,  
show locations of each on sketch.