

Walthall
K 19
12-31-69

MISSISSIPPI
BOARD OF WATER COMMISSIONERS
416 North State Street
Jackson, Mississippi 39201

CODED
CODED

WATER WELL DRILLERS LOG

12-31 1969 R. Woodward Drilling WALTHALL
date well completed firm name county well located


LANDOWNER: <u>M. Shyde Pope</u>	description of formations encountered	from	to
<u>Zylertown, R.I.?</u>			
<u>Zylertown, Miss.</u> (mailing address)	<u>Red Clay</u>	<u>2</u>	<u>18'</u>
WELL LOCATION: sec. <u>8</u> T <u>1</u> N R <u>12</u> E <u>2</u> miles <u>West</u> of <u>Dexter</u> (distance) (direction) (nearest town)	<u>Red sand & gravel</u>	<u>18'</u>	<u>25'</u>
	<u>clay</u>	<u>25'</u>	<u>32'</u>
WELL PURPOSE: <u>HOME</u> (home, irrigation, municipal, industrial)	<u>gravel</u>	<u>32'</u>	<u>104'</u>
WELL COMPLETION DATA:			
(1) diameter (inches) <u>4</u>			
(2) total depth (feet) <u>104</u>			
(3) static water level (feet) <u>96'</u> below top of ground.			
(4) casing <u>PLASTIC</u> , <u>95'</u> (material) (depth)			
_____ if telescope see back. (size)			
(5) screen <u>9'</u> <u>95'</u> (length) (depth to top)			
<u>4"</u> <u>PLASTIC</u> (size) (material)			
(6) pump <u>1</u> <u>2</u> (HP) (yield gpm)			
<u>115V AC</u> (type power)			
(7) electric log <u>NO</u> (yes or no)			
_____ (organization running log)			
(8) how well bottom plugged <u>FLOAT-TYPE</u> <u>BACK WASH VALVE</u>			
DRILLERS REMARKS:			

JAN 28 1970

MISS. Bd. of
WATER COMMISSIONERS

If well telescopes please sketch and show depths.

GROUND LEVEL

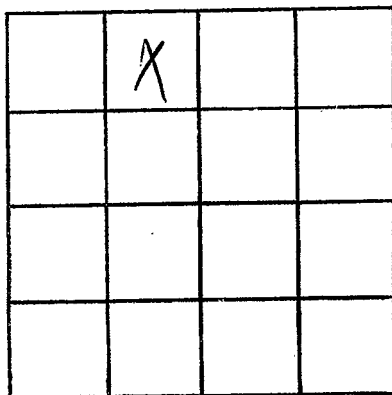

SECTION 8

Please indicate well location X.

ADDITIONAL INFORMATION

If more than one screen, show locations of each on sketch.