

Walthall  
R20,  
1-17-70

MISSISSIPPI  
BOARD OF WATER COMMISSIONERS  
416 North State Street  
Jackson, Mississippi 39201

CODED

CODED

WATER WELL DRILLERS LOG

1-17-70 date well completed 1970 R. Woodward Drilling firm name WALTHALL county well located


LANDOWNER: <u>MR. J. H. SANDIFER</u> <u>RA.?</u>	description of formations encountered	from	to
<u>Lylecatum, Mississippi</u> (mailing address)	<u>Red clay</u>	<u>1</u>	<u>14'</u>
WELL LOCATION: sec <u>5</u> T <u>1</u> N R <u>12</u> E <u>2</u> miles <u>NW</u> of <u>DEXTER</u> (distance) (direction) (nearest town)	<u>Sand gravel</u>	<u>14</u>	<u>81'</u>
WELL PURPOSE: <u>HOME</u> (home, irrigation, municipal, industrial)			
WELL COMPLETION DATA:			
(1) diameter (inches) <u>2"</u>			
(2) total depth (feet) <u>81'</u>			
(3) static water level (feet) <u>75'</u> below top of ground. above			
(4) casing <u>Galvanized</u> , <u>76'</u> (material) (depth) <u>        </u> if telescope see back. (size)			
(5) screen <u>5'</u> , <u>76'</u> (length) (depth to top) <u>2"</u> , <u>Galv. (Gauge type)</u> (size) (material)			
(6) pump <u>1/2</u> , <u>3.5</u> (HP) (yield gpm) <u>115V AC</u> (type power)			
(7) electric log <u>NO</u> (yes or no)			
<u>        </u> (organization running log)			
(8) how well bottom plugged <u>Spring</u> <u>type Back Wash Valve</u>			
DRILLERS REMARKS:			

JAN 28 1970

MISS. BD. OF  
WATER COMM.

If well telescopes please sketch and show depths.

GROUND LEVEL

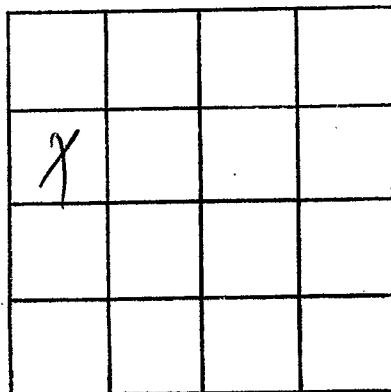

SECTION 5

Please indicate well location X.

ADDITIONAL INFORMATION

If more than one screen,  
show locations of each on sketch.