

CODED

MISSISSIPPI
BOARD OF WATER COMMISSIONERS
416 North State Street
Jackson, Mississippi 39201

WATER WELL DRILLERS LOG

WALTHALL
K22
8-13-70

8-13-1970 date well completed
Stafford Water Well Service firm name
Walthall county well located

LANDOWNER: L.E. Branch

Route 7

Tylertown, Miss (mailing address)

WELL LOCATION:

sec. 26 T 1 N R 12 E 263

4 miles south of Doyon (distance) (direction) (nearest town)

WELL PURPOSE:
(home, irrigation, municipal, industrial)

WELL COMPLETION DATA:

(1) diameter (inches) 4 in

(2) total depth (feet) 200 ft

(3) static water level (feet) 150 below top of ground.

(4) casing Plastic, 200 (material) (depth)

4 in (size) if telescope see back.

(5) screen 10 (length) 190 (depth to top)

4 in, Plastic (size) (material)

(6) pump 1 (HP) 640 gpm (yield gpm)

Electric (type power)

(7) electric log (yes or no)

(organization running log)

(8) how well bottom plugged B.W.V.

description of formations encountered

from to

Chalk 0 15

Sand & Gravel 15 200

CODED


AUG 31 1970

DRILLERS REMARKS:
Clevie Duncan

MISS. BD. OF
WATER COMM.

If well telescopes please sketch and show depths.

GROUND LEVEL

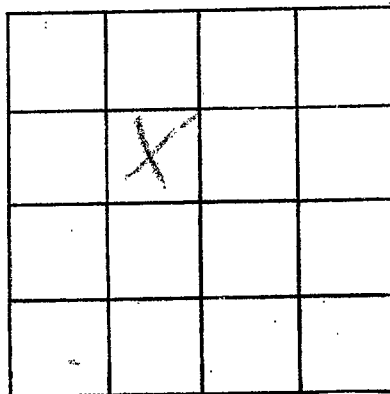

SECTION _____

Please indicate well location X.

ADDITIONAL INFORMATION

If more than one screen, show locations of each on sketch.