

WALTHALL

K23

8-13-70

MISSISSIPPI BOARD OF WATER COMMISSIONERS
416 North State Street
Jackson, Mississippi 39201

CODED

WATER WELL DRILLERS LOG

8-13

date well completed

1970 Staffer's Water Well Service Walthall

firm name

county well located

LANDOWNER: Horse Branch

description of formations encountered

from

to

Route 7

Tylertown, Miss
(mailing address)

Chalk

0

15

WELL LOCATION:

sec. 26 T 1 N R 12 E 263
4 miles South of Depton
(distance) (direction) (nearest town)

Sand & Gravel

15

178

WELL PURPOSE:

(home, irrigation, municipal, industrial)

WELL COMPLETION DATA:

- (1) diameter (inches) 4 in
- (2) total depth (feet) 178
- (3) static water level (feet) 115 below top of ground.
- (4) casing Plastic, 168
(material) (depth)
4 in if telescope see back.
(size)
- (5) screen 12 ft, 168
(length) (depth to top)
4 in, Plastic
(size) (material)
- (6) pump 3/4 25
(HP) (yield gpm)
5 hps
(type power)
- (7) electric log _____
(yes or no)

CODED

(organization running log)

(8) how well bottom plugged BWV

AUG 31 1970


DRILLERS REMARKS:

Cleve Duncan

MISS. DIV. OF
WATER CONTROL

If well telescopes please sketch and show depths.

GROUND LEVEL

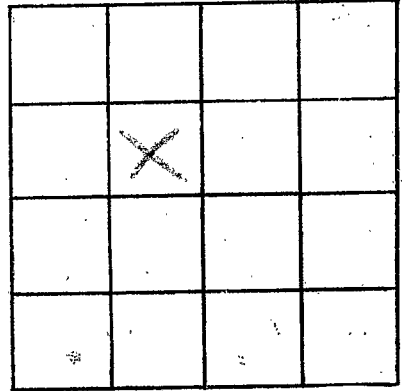

SECTION _____

Please indicate well location X.

ADDITIONAL INFORMATION

If more than one screen, show locations of each on sketch.