

Walthall  
K 25  
7-11-70

MISSISSIPPI  
BOARD OF WATER COMMISSIONERS  
416 North State Street  
Jackson, Mississippi 39201

CODED

WATER WELL DRILLERS LOG

July 11 1970 B. Woodward Drilling Walthall  
date well completed firm name county well located

LANDOWNER: <u>Virgil McBeth</u>	description of formations encountered	from	to
	red clay		23
(mailing address)	sand	23	27
WELL LOCATION: sec. <u>28</u> T. <u>1</u> N. R. <u>12</u> E	clay	27	28
<u>3 1/4</u> miles <u>South</u> of <u>Defton</u>	sand and gravel	40	65
(distance) (direction) (nearest town)	white clay	65	90
WELL PURPOSE: <u>Home</u> (home, irrigation, municipal, industrial)	sand and gravel	90	100
WELL COMPLETION DATA:			
(1) diameter (inches) <u>2"</u>			
(2) total depth (feet) <u>100'</u>			
(3) static water level (feet) <u>45'</u> below top of ground			
(4) casing <u>Plastic</u> , <u>95'</u> (material) (depth)			
(size) if telescope see back.			
(5) screen <u>5'</u> , <u>95'</u> (length) (depth to top)			
<u>2"</u> , <u>Plastic</u> (size) (material)			
(6) pump <u>3/4</u> , <u>6</u> (HP) (yield gpm)			
<u>115 V AC</u> (type power)			
(7) electric log <u>NO</u> (yes or no)			
(organization running log)			
(8) how well bottom plugged <u>float</u>			
<u>Type B W V</u>			

CODED


JUL 28 1970

DRILLERS REMARKS:

MISS. BD. OF  
WATER COMM.

If well telescopes please sketch and show depths.

GROUND LEVEL

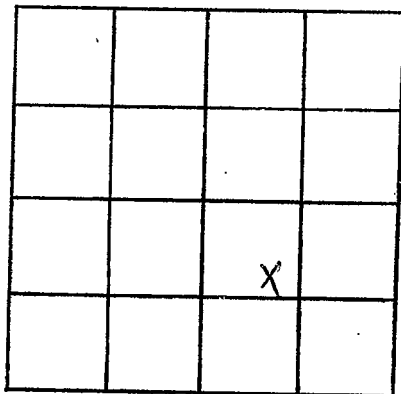

SECTION 28

Please indicate well location X.

ADDITIONAL INFORMATION

Lined area for additional information.

If more than one screen, show locations of each on sketch.