

WALTHALL
K 26
7-22-70

MISSISSIPPI
BOARD OF WATER COMMISSIONERS
416 North State Street
Jackson, Mississippi 39201

CODED

WATER WELL DRILLERS LOG

July 22, 1970 B. Woodward Well Drilling Walthall
date well completed firm name county well located

LANDOWNER:	description of formations encountered	from	to
M. Hershel Stegner	sandy red clay		12'
(mailing address)	white sand and gravel	12'	57'

WELL LOCATION:

sec. 27 T. 1 N R. 12 E
3 miles South Defton
(distance) (direction) (nearest town)

WELL PURPOSE: Dairy farm
(home, irrigation, municipal, industrial)

WELL COMPLETION DATA:

- (1) diameter (inches) 4"
- (2) total depth (feet) 57'
- (3) static water level (feet) 30' below top of ground.
- (4) casing Plastic, 47' (material) (depth)
- (size) if telescope see back.
- (5) screen 10' 47' (length) (depth to top)
- 4" Plastic (size) (material)
- (6) pump 1/3 (HP) 10 (yield gpm)
- 230V AC (type power)
- (7) electric log NO (yes or no)

(organization running log)

(8) how well bottom plugged float
Apr 15 back wash valve

DRILLERS REMARKS:


CODED

ADDC - 3 1970

MISS. Bd. of
Water Comm.

If well telescopes please sketch and show depths.

GROUND LEVEL

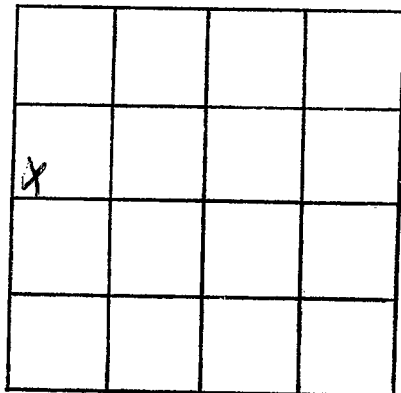

SECTION 27

Please indicate well location X.

ADDITIONAL INFORMATION

Lined area for additional information.

If more than one screen, show locations of each on sketch.