

WALTHALL

K 27

9-30-70

MISSISSIPPI BOARD OF WATER COMMISSIONERS
416 North State Street
Jackson, Mississippi 39201

CODED

WATER WELL DRILLERS LOG

September 30, 1970 R. Woodward Drilling Walthall
date well completed firm name county well located

LANDOWNER: <u>Melvin Ray Branch</u>	description of formations encountered	from	to
<u>Pl. 7</u>	<u>Sandy red clay</u>		<u>12</u>
<u>Lylestown, Miss.</u> (mailing address)		<u>12</u>	<u>38</u>
WELL LOCATION: sec. <u>34</u> T. <u>1</u> N. R. <u>12</u> E. S. <u>4</u>	<u>hard gravel</u>	<u>38</u>	<u>40</u>
<u>1/2</u> miles <u>North</u> of <u>STATELINE</u> (distance) (direction) (nearest town)	<u>pink clay</u>		
WELL PURPOSE: <u>Dom</u> (home, irrigation, municipal, industrial)	<u>hard gravel</u>	<u>40</u>	<u>65</u>
WELL COMPLETION DATA:			
(1) diameter (inches) <u>2"</u>			
(2) total depth (feet) <u>65'</u>			
(3) static water level (feet) <u>35</u> below top of ground.			
(4) casing <u>Plastic</u> , <u>60'</u> (material) (depth)			
<u>2"</u> If telescope see back. (size)			
(5) screen <u>5'</u> , <u>60'</u> (length) (depth to top)			
<u>2"</u> , <u>Plastic</u> (size) (material)			
(6) pump <u>1/2</u> (HP) <u>5 1/2</u> (yield gpm)			
<u>115V AC</u> (type power)			
(7) electric log <u>No</u> (yes or no)			
(organization running log)			
(8) how well bottom plugged <u>float type</u> <u>BWV</u>			

CODED


SEP 26 1970

MISS. Bd. of WATER COM.

DRILLERS REMARKS:

If well telescopes please sketch and show depths.

GROUND LEVEL

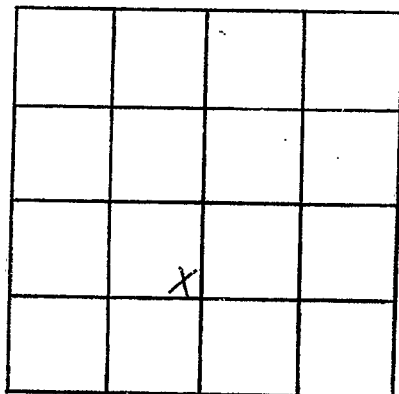

SECTION 34

Please indicate well location X.

ADDITIONAL INFORMATION

Lined area for additional information.

If more than one screen, show locations of each on sketch.