

WALTHALL  
K29  
4-11-72

MISSISSIPPI  
BOARD OF WATER COMMISSIONERS  
416 North State Street  
Jackson, Mississippi 39201

**CODED**

WATER WELL DRILLERS LOG

April 11 1972 B. Woodward Drilling Walthall  
date well completed firm name county well located

LANDOWNER: <u>Harvey Stogner</u>	description of formations encountered	from	to
<u>At. 7</u>	<u>Sandy red clay</u>		<u>21</u>
<u>Tylertown, Miss.</u> (mailing address)	<u>Purple clay</u>	<u>21</u>	<u>48</u>
WELL LOCATION: sec <u>22</u> T <u>1</u> N R <u>12</u> E # <u>3</u> miles <u>South</u> of <u>Daphne</u> (distance) (direction) (nearest town)	<u>Sand and gravel</u>	<u>48</u>	<u>125</u>
WELL PURPOSE: <u>Home</u> (home, irrigation, municipal, industrial)			
WELL COMPLETION DATA:			
(1) diameter (inches) <u>4"</u>			
(2) total depth (feet) <u>105'</u>			
(3) static water level (feet) <u>70</u> below top of ground. above			
(4) casing <u>PVC</u> , <u>95'</u> (material) (depth) <u>4"</u> (size) if telescope see back.			
(5) screen <u>10'</u> , <u>95'</u> (length) (depth to top) <u>4"</u> , <u>PVC</u> (size) (material)			
(6) pump <u>3/4</u> , <u>10</u> (HP) (yield gpm) <u>115 V AC</u> (type power)			
(7) electric log <u>NO</u> (yes or no)			
(organization running log)			
(8) how well bottom plugged <u>float</u> <u>Type B W V</u>			

**CODED**


APR 21 1972

MISS. BD. OF  
WATER COMMISSIONERS

DRILLERS REMARKS:

If well telescopes please sketch and show depths.

GROUND LEVEL

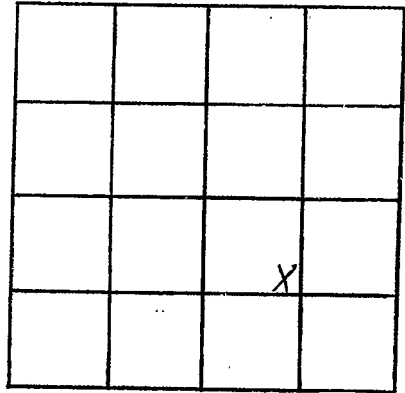

SECTION 22

Please indicate well location X.

ADDITIONAL INFORMATION

If more than one screen,  
show locations of each on sketch.