

**CODED**

WALTHALL

K 30

4-10-72

MISSISSIPPI  
BOARD OF WATER COMMISSIONERS  
416 North State Street  
Jackson, Mississippi 39201

WATER WELL DRILLERS LOG

**CODED**

April 10 1972

date well completed

M. Woodward Drilling

firm name

Walthall

county well located

LANDOWNER: Charles Stogner

description of formations encountered

from

to

Pt. 7

Sandy red clay

25

Tylertown, Miss.  
(mailing address)

Purple clay

25

73

WELL LOCATION:

sec. 22 T 1 N R 12 E

3 miles South of Depton  
(distance) (direction) (nearest town)

Sand and gravel

73

81

white clay

81

95

Gravel

95

110

WELL PURPOSE:

Home  
(home, irrigation, municipal, industrial)

WELL COMPLETION DATA:

- (1) diameter (inches) 4"
- (2) total depth (feet) 110'
- (3) static water level (feet) 76 below above top of ground.
- (4) casing PVC, 100'  
(material) (depth)  
4"  
(size) if telescope see back.
- (5) screen 10', 100'  
(length) (depth to top)  
4" PVC  
(size) (material)
- (6) pump 1 10  
(HP) (yield gpm)  
115V AC  
(type power)
- (7) electric log NO  
(yes or no)

**CODED**

APR 21 1972

MISS. BD. OF  
WATER COMM.


(organization running log)

(8) how well bottom plugged float-  
light-BWL

DRILLERS REMARKS:

If well telescopes please sketch and show depths.

GROUND LEVEL

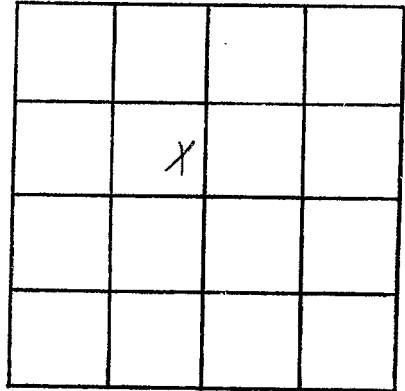

SECTION 22

Please indicate well location X.

ADDITIONAL INFORMATION

Lined area for additional information.

If more than one screen, show locations of each on sketch.