

WALTHALL
K 31
3-29-72

MISSISSIPPI
BOARD OF WATER COMMISSIONERS
416 North State Street
Jackson, Mississippi 39201

WATER WELL DRILLERS LOG

March 29 1972 Chestnut Hill Walthall
date well completed firm name county well located

LANDOWNER: R. W. King
RTD, Tylertown
(mailing address)

description of formations encountered	from	to
	<u>Red Clay</u>	<u>0</u>
<u>Red Sand</u>	<u>14</u>	<u>82</u>
<u>Mixed Sand & Gravel</u>	<u>82</u>	<u>109</u>

WELL LOCATION:
sec. 7 T. 1 N. R. 12 E
6 miles SE of Tylertown
(distance) (direction) (nearest town)

WELL PURPOSE: Drainage
(home, irrigation, municipal, industrial)


- WELL COMPLETION DATA:
- (1) diameter (inches) 4"
 - (2) total depth (feet) 109
 - (3) static water level (feet) 69 below/above top of ground.
 - (4) casing Plast Ballam
(material) (depth)
 - _____ if telescope see back.
(size)
 - (5) screen 6' 103
(length) (depth to top)
 - 4" Plast
(size) (material)
 - (6) pump 3/4 HP 15
(HP) (yield gpm)
 - Electric
(type power)
 - (7) electric log NO
(yes or no)
 - _____ (organization running log)

(8) how well bottom plugged wooden plug

DRILLERS REMARKS: Red 2'
well bad

If well telescopes please sketch and show depths.

GROUND LEVEL

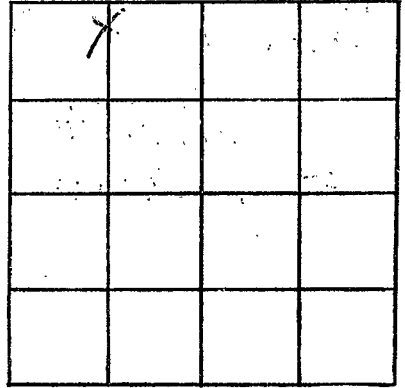

SECTION 7

Please indicate well location X.

ADDITIONAL INFORMATION

Lined area for additional information.

If more than one screen, show locations of each on sketch.