

CODED

MISSISSIPPI
BOARD OF WATER COMMISSIONERS
416 North State Street
Jackson, Mississippi 39201

WALTHALL
K 33
9-19-72

WATER WELL DRILLERS LOG

9-19-72 19 Per Martin Miller Well with 10
date well completed firm name county well located

LANDOWNER: Lee Edgar Brannon
RT-7 - Box 112 -
Tylertown, Miss
(mailing address)
WELL LOCATION:
sec. 29 T. 1 S. R. 19 E.
18 miles S/E of Tylertown
(distance) (direction) (nearest town)

description of formations encountered	from	to
<u>Top clay</u>	<u>0</u>	<u>20</u>
<u>Dry sand</u>	<u>20</u>	<u>76</u>
<u>Chalk</u>	<u>70</u>	<u>95</u>
<u>Hard sand</u>	<u>95</u>	<u>100</u>
<u>Walt sand</u>	<u>100</u>	<u>130</u>

WELL PURPOSE: None
(home, irrigation, municipal, industrial)

WELL COMPLETION DATA:
(1) diameter (inches) 4"
(2) total depth (feet) 120
(3) static water level (feet) 73 below above top of ground.
(4) casing pvc 110
(material) (depth)
(size) if telescope see back.
(5) screen 10" 110
(length) (depth to top)
4" pvc
(size) (material)
(6) pump 1/2 8
(HP) (yield gpm)
220 volt ac
(type power)
(7) electric log (yes or no)
(organization running log)

CODED

(8) how well bottom plugged Sand trap backwash


OCT 21 1972

MISS. BD. OF
WATER CONTROL

DRILLERS REMARKS:

If well telescopes please sketch and show depths.

GROUND LEVEL

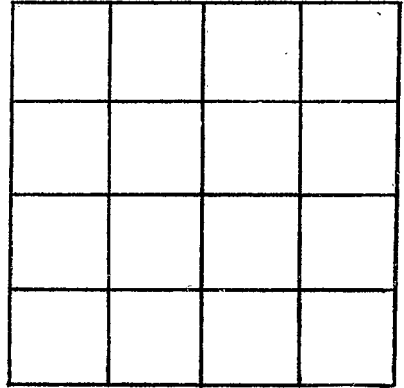

SECTION _____

Please indicate well location X.

ADDITIONAL INFORMATION

If more than one screen,
show locations of each on sketch.