

WALTHALL

K 34

11-15-72

MISSISSIPPI  
 BOARD OF WATER COMMISSIONERS  
 416 North State Street  
 Jackson, Mississippi 39201

WATER WELL DRILLERS LOG

11-15

1972

per Metropolitan Water Well

Walthall

date well completed

firm name

county well located

LANDOWNER:

Mr. Carl E. Forbes

RT-7, Gylbertown, Miss.  
(mailing address)

description of formations encountered

from

to

Top Clay + Sand

0 20

Dry sand

20 55

Fine sand

55 65

grey gravel

65 70

White Chalk

70 83

Fine sand

83 100

Water sand

100 130

WELL LOCATION:

sec 21 T 1 N R 12 E

15 miles S-E Gylbertown  
(distance) (direction) (nearest town)

WELL PURPOSE:

Home -  
(home, irrigation, municipal, industrial)

WELL COMPLETION DATA:

(1) diameter (inches) 4"

(2) total depth (feet) 130

(3) static water level (feet) 70 below above top of ground.

(4) casing PVC 120  
(material) (depth)

(size) if telescope see back.

(5) screen 10 120  
(length) (depth to top)

.012 PVC  
(size) (material)

(6) pump 1 20  
(HP) (yield gpm)

220 Volt AC  
(type power)

(7) electric log no  
(yes or no)

(organization running log)

(8) how well/bottom plugged  
Sandy Shale back Washed


NOV 22 1972

WATER LOG

DRILLERS REMARKS:

If well telescopes please sketch and show depths.

GROUND LEVEL

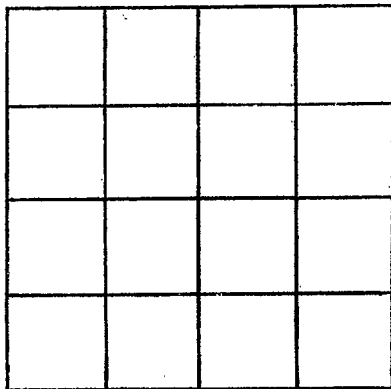

SECTION \_\_\_\_\_

Please indicate well location X.

ADDITIONAL INFORMATION

If more than one screen,  
show locations of each on sketch.