

WALTHALL  
K 35  
11-11-72

MISSISSIPPI  
BOARD OF WATER COMMISSIONERS  
416 North State Street  
Jackson, Mississippi 39201

CODED

WATER WELL DRILLERS LOG

Nov. 11 19 72 Robert Water Well Walthall  
date well completed firm name county well located


LANDOWNER: <u>Mr. Keith Stegner</u>	description of formations encountered	from	to
<u>RT-7.</u>	<u>Top sand</u>	<u>0</u>	<u>10</u>
<u>Zylertown miss.</u> (mailing address)	<u>Clay &amp; gravel</u>	<u>10</u>	<u>21</u>
WELL LOCATION: sec. <u>22-T 1</u> <u>S</u> R <u>12</u> <u>E</u>	<u>Dry sand</u>	<u>21</u>	<u>40</u>
<u>16</u> miles <u>S.E.</u> of <u>Zylertown</u> (distance) (direction) of (nearest town)	<u>pl. Gravel</u>	<u>40</u>	<u>45</u>
WELL PURPOSE: <u>pond</u> (home, irrigation, municipal, industrial)	<u>Level sand</u>	<u>45</u>	<u>70</u>
WELL COMPLETION DATA:	<u>Water sand</u>	<u>70</u>	<u>100</u>
(1) diameter (inches) <u>4"</u>			
(2) total depth (feet) <u>100</u>			
(3) static water level (feet) <u>60'</u> below above top of ground.			
(4) casing <u>PVC</u> <u>90</u> (material) (depth)			
(size) if telescope see back.			
(5) screen <u>10'</u> <u>90'</u> (length) (depth to top)			
(size) <u>1/2"</u> <u>PVC</u> (material)			
(6) pump <u>1 h.p.</u> <u>20</u> (HP) (yield gpm)			
<u>220 Volts A.C.</u> (type power)			
(7) electric log <u>no</u> (yes or no)			
(organization running log)			
(8) how well bottom plugged <u>sand trap back used</u>			
DRILLERS REMARKS: <u>a very good well and very good drilling</u>			

CODED

NOV 22 1972

If well telescopes please sketch and show depths.

GROUND LEVEL

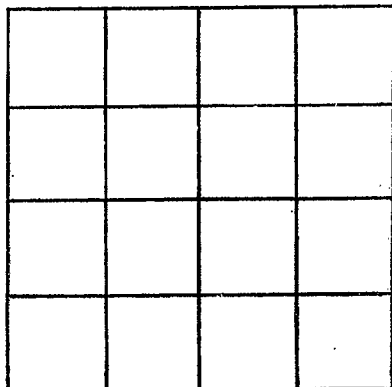

SECTION \_\_\_\_\_

Please indicate well location X.

ADDITIONAL INFORMATION

If more than one screen,  
show locations of each on sketch.