

WALTHALL
K36
9-14-72

MISSISSIPPI
BOARD OF WATER COMMISSIONERS
416 North State Street
Jackson, Mississippi 39201

CODED

WATER WELL DRILLERS LOG

Sept 14 1972 date well completed
Chester Reeves firm name
Walthall county well located

LANDOWNER: Red Henning
Rt 2 - Tyler town
(mailing address)

WELL LOCATION:
sec. 12 T 1 N R. 12 E
3 miles E of Depler
(distance) (direction) (nearest town)

WELL PURPOSE: Farm
(home, irrigation, municipal, industrial)

WELL COMPLETION DATA:

- (1) diameter (inches) 4"
- (2) total depth (feet) 141
- (3) static water level (feet) 85 below above top of ground.
- (4) casing Plast. Bottom
(material) (depth)
- (5) screen 6' 135'
(length) (depth to top)
4" Plast.
(size) (material)
- (6) pump 1 Sub 20
(HP) (yield gpm)
Elect.
(type power)
- (7) electric log No.
(yes or no)

(organization running log)

(8) how well bottom plugged
wood plug

DRILLERS REMARKS:

description of formations encountered	from	to
red sandy clay	0	19
red sand	19	42
Sand & gravel	42	50
white chalk	50	83
loblolly sand	83	107
Sand & gravel	107	122
black chalk	122	127
Red gravel & sand	127	141


CODED

DEC 1 1972

MISS. Bd. of
WATER COM.

If well telescopes please sketch and show depths.

GROUND LEVEL

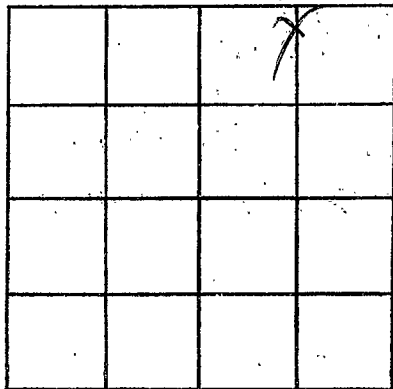

SECTION 12

Please indicate well location X.

ADDITIONAL INFORMATION

If more than one screen,
show locations of each on sketch.