

WALTHALL
K 37
11-1-72

MISSISSIPPI
BOARD OF WATER COMMISSIONERS
416 North State Street
Jackson, Mississippi 39201

CODED

WATER WELL DRILLERS LOG

NOV-1 1972 date well completed
chester reeves firm name
walthall county well located

LANDOWNER: Dr. Walter W. Slogner
Tylertown
(mailing address)

WELL LOCATION:
sec. 2 T. 1 N. R. 12 E
2 miles E of Dexter
(distance) (direction) (nearest town)

WELL PURPOSE: drain
(home, irrigation, municipal, industrial)

WELL COMPLETION DATA:

- (1) diameter (inches) 4"
- (2) total depth (feet) 130
- (3) static water level (feet) 4.5 below top of ground.
- (4) casing Plast Ballast
(material) (depth)
- _____ If telescope see back.
(size)
- (5) screen 6' 12"
(length) (depth to top)
- 4" Plast
(size) (material)
- (6) pump 1/2 HP 12
(HP) (yield gpm)
- Electric
(type power)
- (7) electric log No
(yes or no)
- _____ (organization running log)

description of formations encountered	from	to
Red clay	0	16
Red sand	16	44
Red gravel sand	44	60
chalk	60	87
Red gravel sand	87	102
Sandy sand	102	114
Coarse sand & red gravel	114	130


CODED

MAR 13 1972

DRILLERS REMARKS:
New house.

If well telescopes please
sketch and show depths.

GROUND LEVEL

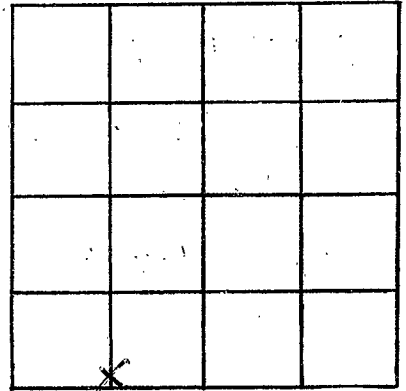

SECTION 2

Please indicate well location X.

ADDITIONAL INFORMATION

If more than one screen,
show locations of each on sketch.