

WALTHALL
K 38
2-7-73

MISSISSIPPI
BOARD OF WATER COMMISSIONERS
416 North State Street
Jackson, Mississippi 39201

CODED

WATER WELL DRILLERS LOG

Feb 7 1973 date well completed
Chester Keene firm name
Walthall county well located

LANDOWNER: Irving Wood
Rt 1
Tylertown
(mailing address)

description of formations encountered

from

to

Red clay	0	17
Red sand	17	62
Sand & gravel	62	85
Runb chalk	85	89

WELL LOCATION:

sec 31 T 1 N R 12 E
8 miles SE Tylertown
(distance) (direction) (nearest town)

WELL PURPOSE: House
(home, irrigation, municipal, industrial)

4" blank pipe set
below screen

WELL COMPLETION DATA:

- (1) diameter (inches) 4"
- (2) total depth (feet) 89
- (3) static water level (feet) 69 below top of ground.
- (4) casing: Plast bottom
(material) (depth)
- _____ if telescope see back.
(size)
- (5) screen: 6' 83'
(length) (depth to top)
- 4" Plast
(size) (material)
- (6) pump: Rump hyower
(HP) (yield gpm)
- elect
(type power)
- (7) electric log No-
(yes or no)

CODED

(organization running log)


(8) how well bottom plugged: wooden plug

FEB 8 1973

DRILLERS REMARKS:

If well telescopes please
sketch and show depths.

GROUND LEVEL

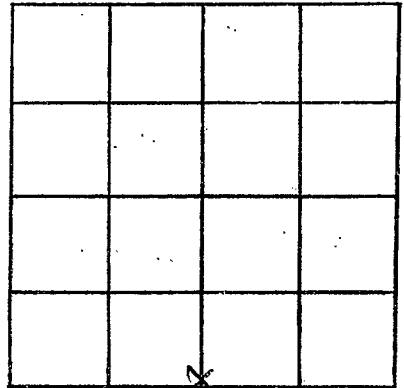

SECTION 31

Please indicate well location X.

ADDITIONAL INFORMATION

If more than one screen,
show locations of each on sketch.