

WALTHALL
K 39
2-7-73

MISSISSIPPI
BOARD OF WATER COMMISSIONERS
416 North State Street
Jackson, Mississippi 39201

CODED

WATER WELL DRILLERS LOG

Feb-7 1973 Chester Beems Walthall
date well completed firm name county well located

LANDOWNER: Johnny Ward
Atty, Tylertown
(mailing address)

description of formations encountered	from	to
Red clay	0	17
Red sand	17	41
Red chalk	41	62
Sand & gravel	62	80

WELL LOCATION:
sec. 31 T. 1 N. R. 12 E
8 miles SE Tylertown
(distance) (direction) (nearest town)

WELL PURPOSE: Home-
(home, irrigation, municipal, industrial)

WELL COMPLETION DATA:

- (1) diameter (inches) 4"
- (2) total depth (feet) 80
- (3) static water level (feet) 70 below top of ground.
- (4) casing Plast Bottom
(material) (depth)
- _____ if telescope see back.
(size)
- (5) screen 6' 74'
(length) (depth to top)
- 4" Plast
(size) (material)
- (6) pump Pump house
(HP) (yield gpm)
- _____ (type power)
- (7) electric log NO.
(yes or no)
- _____ (organization running log)

CODED


(8) how well bottom plugged
wooden plug -

DRILLERS REMARKS:

1973

If well telescopes please sketch and show depths.

GROUND LEVEL

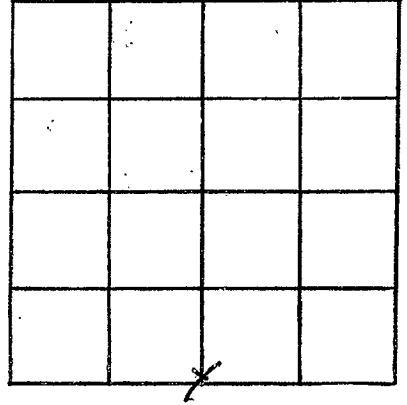

SECTION 31

Please indicate well location X.

ADDITIONAL INFORMATION

If more than one screen,
show locations of each on sketch.