

WALTHAM
K40
4-15-74

MISSISSIPPI
BOARD OF WATER COMMISSIONERS **CODED**
 416 North State Street
 Jackson, Mississippi 39201

WATER WELL DRILLERS LOG

4/15/74 date well completed 1974 Earley Stafford Well Serv. Waltham firm name _____ county well located

LANDOWNER: Lloyd Jones
Sandy Hook, Miss.
 (mailing address)

description of formations encountered	from	to
0-20 Chalk	0	20

WELL LOCATION:
 sec 26 T 1 N R 12 E
7 miles south of Dexter
 (distance) (direction) (nearest town)

Sand + clay gravel	20	90
clay + gravel	90	158


WELL PURPOSE: home
 (home, irrigation, municipal, industrial)

- WELL COMPLETION DATA:**
- (1) diameter (inches) 4"
 - (2) total depth (feet) 158"
 - (3) static water level (feet) 20" below top of ground.
 - (4) casing galv. 138"
 (material) (depth)
4" if telescope see back.
 (size)
 - (5) screen 20 ft. 138 ft.
 (length) (depth to top)
4 in. galv.
 (size) (material)
 - (6) pump 1 800 gal/hr.
 (HP) (yield gpm)
Electric
 (type power)
 - (7) electric log _____
 (yes or no)

 (organization running log)
 - (8) how well bottom plugged B.W.O.

CODED

DRILLERS REMARKS:
Clevis Duncan

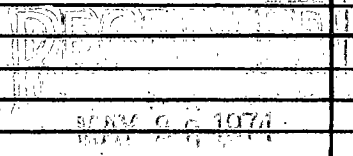

If well telescopes, please sketch and show depths.

MISSISSIPPI
BOARD OF WATER COMMISSIONERS
 JACKSON, MISSISSIPPI 39201
WATER WELL DRILLERS LOG

GROUND LEVEL

Name of flow system

Well name

Description of formation encountered

Depth

Feet

Section (horizontal, diagonal, vertical)

SECTION

(horizontal, diagonal, vertical)
 Please indicate well location X.

ADDITIONAL INFORMATION

(optional) rate

(optional) depth

Water (optional) (optional) (optional)

(optional) (optional)

(optional) (optional)

If more than one screen, show locations of each on sketch.

23 JAN 1961