

Walthall  
K 42  
5-15-74

MISSISSIPPI  
BOARD OF WATER COMMISSIONERS  
416 North State Street  
Jackson, Mississippi 39201

CODED

WATER WELL DRILLERS LOG

5/15 1974 Red Mountain Water Well Walthall Miss  
date well completed firm name county well located

LANDOWNER: Willie Jones  
Route 7  
Tylertown, Miss  
(mailing address)

description of formations encountered	from	to
Top clay	0	8
Top sand	8	40
Pls shale	40	55
Course sand	55	70
Red chalk at	70	

WELL LOCATION:  
sec. 32 T-1 (N) R-12 (E)  
S W  
1.3 miles Southeast of Tylertown  
(distance) (direction) (nearest town)

WELL PURPOSE: Home  
(home, irrigation, municipal, industrial)

WELL COMPLETION DATA:

(1) diameter (inches) 4"  
(2) total depth (feet) 70'  
(3) static water level (feet) 55' below above top of ground.  
(4) casing P.V.C. 60'  
(material) (depth)  
(size) if telescope see back.  
(5) screen 10' 60'  
(length) (depth to top)  
0 1/2" Sch-40 PVC  
(size) (material)  
(6) pump 1/2 HP 8  
(HP) (yield gpm)  
220 AC  
(type power)  
(7) electric log (yes or no)  
(organization running log)  
(8) how well bottom plugged

CODED


MAY 21 1974

MISS. BD. OF WATER COMMISSIONERS

DRILLERS REMARKS:

If well telescopes please sketch and show depths.

GROUND LEVEL

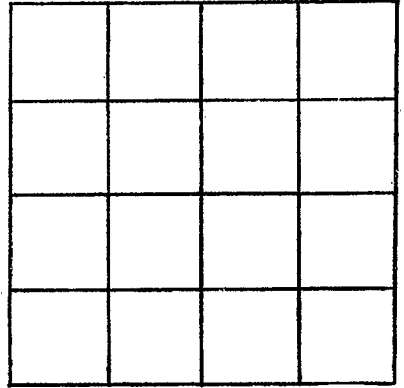

SECTION \_\_\_\_\_

Please indicate well location X.

ADDITIONAL INFORMATION

If more than one screen,  
show locations of each on sketch.