

Walthall
 K 43
 7-17-75

MISSISSIPPI
 BOARD OF WATER COMMISSIONERS
 416 North State Street
 Jackson, Mississippi 39201

CODED

WATER WELL DRILLERS LOG

July 17/75 date well completed STAFFORD WELLS SEC firm name WALTHALL county well located

LANDOWNER: Henry Brough

description of formations encountered

from to

Sylantown Miss
 (mailing address)

top soil	0	10
clay gravel	10	60
ch. sh.	60	85
sand	85	115

WELL LOCATION:

sec. 3 T. 1 N. S. R. 12 E. W. 130
1 miles east of Dexter
 (distance) (direction) (nearest town)

WELL PURPOSE:

(home, irrigation, municipal, industrial)

WELL COMPLETION DATA:


- (1) diameter (inches) 4"
- (2) total depth (feet) 115 ft.
- (3) static water level (feet) 85 below above top of ground.
- (4) casing plastic 102 ft.
 (material) (depth)
4"
 (size) if telescope see back.
- (5) screen 10 ft. 105
 (length) (depth to top)
4" plastic
 (size) (material)
- (6) pump _____ (HP) _____ (yield gpm)

 (type power)
- (7) electric log _____ (yes or no)

 (organization running log)
- (8) how well bottom plugged B.W.V.


DRILLERS REMARKS:

L. Magee Ryba

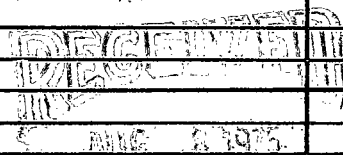

If well telescopes please sketch and show depths.

GROUND LEVEL

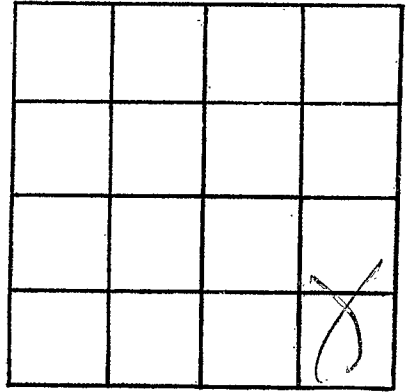

SECTION _____

Please indicate well location X.

ADDITIONAL INFORMATION

Lined area for additional information.

If more than one screen, show locations of each on sketch.