

Walthall
K 44
7

MISSISSIPPI
BOARD OF WATER COMMISSIONERS
416 North State Street
Jackson, Mississippi 39201

CODED

WATER WELL DRILLERS LOG


date well completed Oct. 5 1975 firm name Stallard Well Dr. county well located WALTHALL

| LANDOWNER: | description of formations encountered | from | to |
|--|---------------------------------------|------|----|
| <u>WILLARD WRIGHT</u> <u>147</u> <u>Jackson, Miss</u> (mailing address) | | | |
| WELL LOCATION: | | | |
| sec. <u>3</u> T. <u>1</u> N. R. <u>12</u> E. <u>13</u> W. | | | |
| <u>1</u> miles <u>NE</u> of <u>Dexter</u> (distance) (direction) (nearest town) | | | |
| WELL PURPOSE: (home, irrigation, municipal, industrial) | | | |
| WELL COMPLETION DATA: | | | |
| (1) diameter (inches) <u>4"</u> | | | |
| (2) total depth (feet) <u>105 ft.</u> | | | |
| (3) static water level (feet) <u>80 ft.</u> below top of ground. | | | |
| (4) casing <u>plastic 95'</u> (material) (depth) | | | |
| <u>4"</u> (size) if telescope see back. | | | |
| (5) screen <u>10 ft. 95'</u> (length) (depth to top) | | | |
| <u>4"</u> (size) <u>plastic</u> (material) | | | |
| (6) pump <u>1/2 hp</u> <u>10</u> (HP) (yield gpm) | | | |
| <u>Elec.</u> (type power) | | | |
| (7) electric log <u>yes or no</u> | | | |
| (organization running log) | | | |
| (8) how well bottom plugged <u>B.W.O.</u> | | | |
| DRILLERS REMARKS: <u>Jalmerge Risher</u> | | | |

RECEIVED
MAY 8 1975

If well telescopes please sketch and show depths.

GROUND LEVEL

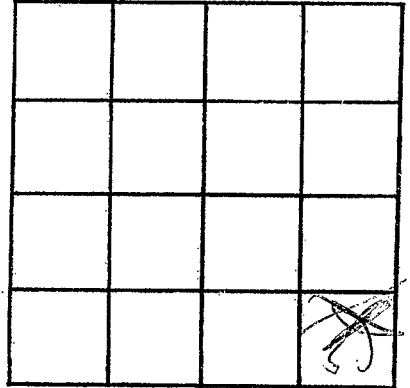

SECTION _____

Please indicate well location X.

ADDITIONAL INFORMATION

If more than one screen,
show locations of each on sketch.