

Walthall
K 45
7-17-75

MISSISSIPPI
BOARD OF WATER COMMISSIONERS
416 North State Street
Jackson, Mississippi 39201

CODED

WATER WELL DRILLERS LOG

7/17 1975 STAFFORD WELL^{SR} WALTHALL
date well completed firm name county well located

LANDOWNER: Vainy Broghina

description of formations encountered

from to

Jefferson, Miss
(mailing address)

top soil	0	10
clay channel	10	50
shell	50	75
sand	75	100

WELL LOCATION:
sec. 3 T. 1N S. R. 12E ^{13V}
1 miles east of Dexter
(distance) (direction) (nearest town)

WELL PURPOSE:
(home, irrigation, municipal, industrial)


WELL COMPLETION DATA:

- (1) diameter (inches) 4"
- (2) total depth (feet) 100 ft.
- (3) static water level (feet) 80 below above top of ground
- (4) casing plastic 90
(material) (depth)
4"
(size) if telescope see back.
- (5) screen 18" 90
(length) (depth to top)
4" plastic
(size) (material)
- (6) pump 1/2 hp 10
(HP) (yield gpm)
elec.
(type power)
- (7) electric log (yes or no) _____
(organization running log) _____
- (8) how well bottom plugged BWU

DRILLERS REMARKS:
~~_____~~
~~_____~~
Johnnie Lybe

If well telescopes please sketch and show depths.

GROUND LEVEL

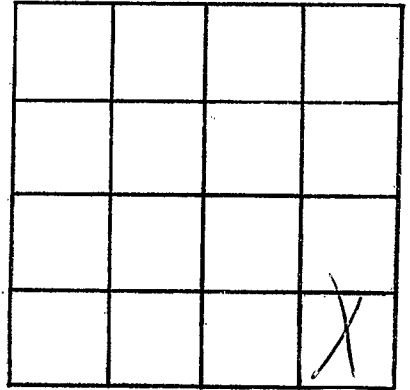

SECTION _____

Please indicate well location X.

ADDITIONAL INFORMATION

Lined area for additional information.

If more than one screen, show locations of each on sketch.