

WALTHALL

K 46

11/13/77

MISSISSIPPI
BOARD OF WATER COMMISSIONERS
416 North State Street
Jackson, Mississippi 39201

CODED

WATER WELL DRILLERS LOG

11/13/77
date well completed

Graver Drilling Service
firm name

Walthall Co.
county well located

LANDOWNER: Getty Oil Co
Larcolville Co.
Pitman, MO #1
(mailing address)

| description of formations encountered | from | to |
|---------------------------------------|------|------|
| Sand + Gravel | 0 | 300' |
| Sand | 301 | 360 |
| Sand + Gravel | 361 | 328 |

WELL LOCATION:

sec. 1 T. 1 N R. 12 E
1500' N + 1140' W of SE cor of Tylertown
(distance) miles (direction) of (nearest town)

WELL PURPOSE:

(home, irrigation, municipal, industrial)

WELL COMPLETION DATA:

- (1) diameter (inches) 3"
- (2) total depth (feet) 378'
- (3) static water level (feet) 100 ^{below} _{above} top of ground.
- (4) casing Steel 357'
(material) (depth)
- (size) If telescope see back.
- (5) screen 42' 315'
(length) (depth to top)
- 3" Perforated Pipe
(size) (material)
- (6) pump — 75
(HP) (yield gpm)
- AC
(type power)
- (7) electric log N.O.
(yes or no)
- (organization running log)

CODED

RECEIVED

NOV 25 1977


(8) how well bottom plugged Orange
peel

DRILLERS REMARKS:

WATER COMMISSIONERS

If well telescopes please sketch and show depths.

GROUND LEVEL

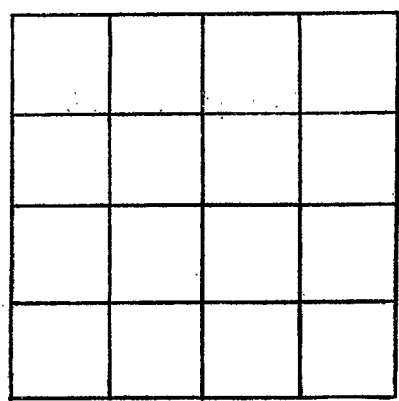

SECTION _____

Please indicate well location X.

ADDITIONAL INFORMATION

A series of horizontal lines for recording additional information, starting below the 'ADDITIONAL INFORMATION' header and extending to the bottom of the page.

If more than one screen, show locations of each on sketch.