

BOARD OF WATER COMMISSIONERS
416 North State Street
Jackson, Mississippi 39201

CODED

K 47
3/7/78

WATER WELL DRILLERS LOG

3/7/1978 19 Griner Drilling Service Walthall Co.
date well completed firm name county well located

LANDOWNER: Pennigot
Producing Co. Prist Co.
#1 Dexterfield
(mailing address)

description of formations encountered	from	to
<u>sand gravel</u>	<u>0</u>	<u>147</u>
<u>Chalk</u>	<u>147</u>	<u>210</u>
<u>Sand, Gravel</u>	<u>210</u>	<u>399</u>

WELL LOCATION:
sec. 12 T. 1 N. R. 12 E
1500'S & 1000'E of NW/Cor W
miles (distance) of (direction) of (nearest town)

CODED

WELL PURPOSE:
(home, irrigation, municipal, industrial)


- WELL COMPLETION DATA:
- (1) diameter (inches) 3
 - (2) total depth (feet) 420
 - (3) static water level (feet) 40 below top of ground.
 - (4) casing Steel 399
(material) (depth)
3"
(size) if telescope see back.
 - (5) screen 42' 357'
(length) (depth to top)
3" Perforated Pipe
(size) (material)
 - (6) pump — 75
(HP) (yield gpm)
AC
(type power)
 - (7) electric log NO
(yes or no)
 - (organization running log)
 - (8) how well bottom plugged Orange
peel

DRILLERS REMARKS:

RECEIVED
MAR 30 1978

If well telescopes please sketch and show depths.

GROUND LEVEL

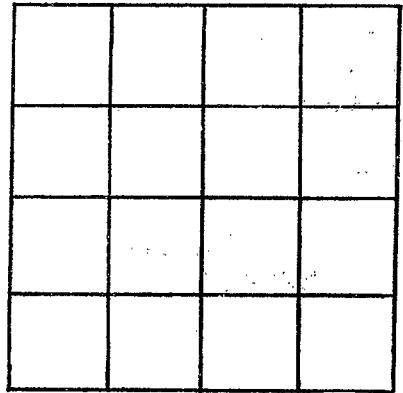

SECTION _____

Please indicate well location X.

ADDITIONAL INFORMATION

If more than one screen,
show locations of each on sketch.