

MISSISSIPPI DEPARTMENT OF NATURAL RESOURCES

Bureau of Land and Water Resources

Southport Mall

P.O. Box 10631

Jackson, Mississippi 39209

CODED

WATER WELL DRILLERS LOG

Griner Drilling Service

Walthall

WALTHALL
K 54
12-9-81
12-9-81

date well completed

firm name

county well located

LANDOWNER:
Celt Oil, Inc.
P.O. Box 5757
Shreveport, La
(mailing address)

description of formations encountered

from

to

Sand, pea gravel

0

357

WELL LOCATION: 1040' N 4165' E
No. 1 sec. 2 T 1 N R 12 E SW 1/4
Fortenberry Dexter Field
(distance) miles (direction) of (nearest town)

WELL PURPOSE: oil field supply
(home, irrigation, municipal, industrial)

WELL COMPLETION DATA:

CODED

- (1) diameter (inches) 3"
- (2) total depth (feet) 357'
- (3) static water level (feet) 30' below top of ground
- (4) casing steel 357' (material), (depth)
3" (size) If telescope see back.
- (5) screen 42' 315' (length), (depth to top)
3" perforated (size), (material)
- (6) pump — 70 (HP), (yield gpm)
AC (type power)
- (7) electric log — (yes or no)

(organization running log)

- (8) how well bottom plugged Orange peel

DRILLERS REMARKS:


DEPT. OF NATURAL RESOURCES
BUREAU OF LAND & WATER RESOURCES

DEC 23 1981

RECEIVED

If well telescopes please sketch and show depths.

GROUND LEVEL

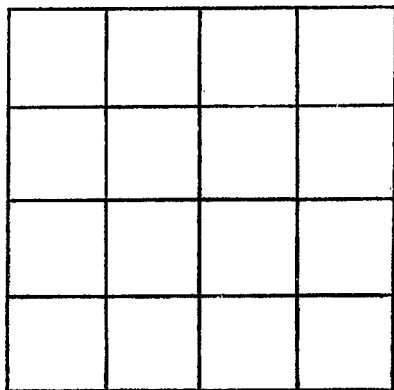

SECTION _____

Please indicate well location X.

ADDITIONAL INFORMATION

If more than one screen,
show locations of each on sketch.