

MISSISSIPPI DEPARTMENT OF NATURAL RESOURCES

Bureau of Land and Water Resources

Southport Mall

P.O. Box 10631

Jackson, Mississippi 39209

WATER WELL DRILLERS LOG

INDEXED

Walthall
K55
5-18-82

Griner Drilling Service, Inc.

Walthall

5-18-82 date well completed

Griner Drilling Service, Inc. firm name

Walthall county well located

LANDOWNER:
Getty Oil Corporation
P.O. Box 16878
Mobile, Ala. 36616
(mailing address)

description of formations encountered	from	to
Chalk	0	21
chalk, sand	21	42
sand, pea gravel	42	168
chalk	168	189
sand, pea gravel	189	378

WELL LOCATION: 2100W + 600W
Nor. sec. 2, T-16S, R-120E, S10W
Morris Dexter Field
2.9 miles (distance) (direction) of (nearest town)

WELL PURPOSE: oilfield supply
(home, irrigation, municipal, industrial)

WELL COMPLETION DATA:

- (1) diameter (inches) 3"
- (2) total depth (feet) 378'
- (3) static water level (feet) 60 below above top of ground.
- (4) casing steel, 378' (material) (depth)
3" (size) if telescope see back.
- (5) screen 42', 336' (length) (depth to top)
3", perforated (size) (material)
- (6) pump —, 80 (HP) (yield gpm)
AC (type power)
- (7) electric log — (yes or no)
— (organization running log)
- (8) how well bottom plugged orange pebb

DRILLERS REMARKS:


DEPT. OF NATURAL RESOURCES
BUREAU OF LAND & WATER RESOURCES

JUN - 1 1982

RECEIVED

If well telescopes please sketch and show depths.

GROUND LEVEL

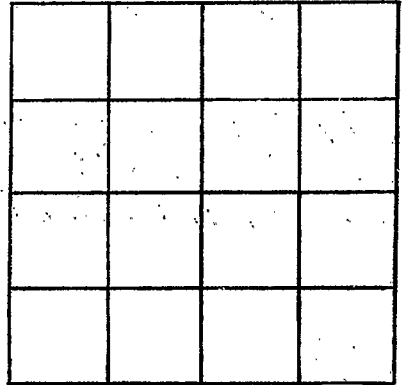

SECTION _____

Please indicate well location X.

ADDITIONAL INFORMATION

If more than one screen, show locations of each on sketch.