

WALTHALL
K 56
6-4-82

MISSISSIPPI
BOARD OF WATER COMMISSIONERS
416 North State Street
Jackson, Mississippi 39201

WATER WELL DRILLERS LOG

June 4 1982 - TOM GRIFFITH - Walthall
date well completed PLUMBING & WELL SERVICE, INC. county well located

LANDOWNER:	description of formations encountered	from	to
Simmons Welding (mailing address)	0-20 Sand Pan Gravel		
WELL LOCATION: sec. 34 T-1 N S R-12 E 7 miles S of Defters (distance) (direction) (nearest town)	26-38 Chalk		
WELL PURPOSE: (home, irrigation, municipal, industrial)	38-200 Sand Gravel		
WELL COMPLETION DATA:			
(1) diameter (inches) 4"			
(2) total depth (feet) 200 ft			
(3) static water level (feet) 95 below top of ground.			
(4) casing (material) Plastic (depth) 180			
(size) if telescope see back.			
(5) screen (length) 20 ft (depth to top) 180			
(size) 4" PVC (material)			
(6) pump (HP) 3 (yield gpm) 50			
(type power)			
(7) electric log (yes or no)			
(organization running log)			
(8) how well bottom plugged Bury			
DRILLERS REMARKS:			


DEPT. OF NATURAL RESOURCES
BUREAU OF LAND & WATER RESOURCES

JUN 25 1982

RECEIVED

If well telescopes please sketch and show depths.

GROUND LEVEL

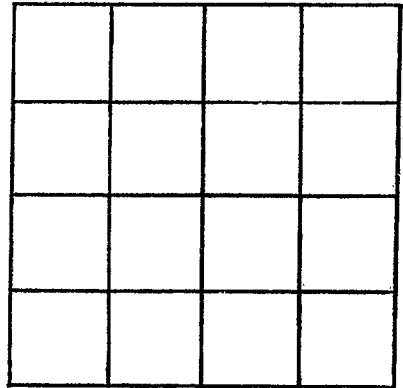

SECTION _____

Please indicate well location X.

ADDITIONAL INFORMATION

If more than one screen,
show locations of each on sketch.