

WALTHALL
K. 57
10/25/82

MISSISSIPPI DEPARTMENT OF NATURAL RESOURCES
Bureau of Land and Water Resources
Southport Mall
P.O. Box 10631
Jackson, Mississippi 39209
WATER WELL DRILLERS LOG

Griner Drilling
Service, Inc.

Walthall

10-25-82
date well completed

firm name

county well located

LANDOWNER:

Exeter Drilling
144 Elk Place
Suite 1502

description of formations
encountered

from

to

sand, gravel

0 168

New Orleans, La. 70112
(mailing address)

clay, streaked

168 273

WELL LOCATION: 200'S + 500' W

sec. 10 T. 1 N. R. 12 E NE 1/4
No. 1
Merarey
UNIT 10-3
Dexter Field

sand, pea gravel

273 400

10-3 miles (distance) of Dexter Field (direction) of (nearest town)

WELL PURPOSE: oil field sand
(home, irrigation, municipal, industrial)

WELL COMPLETION DATA:

(1) diameter (inches) 3"

(2) total depth (feet) 406'

(3) static water level (feet) 80' below top of ground.

(4) casing steel, 406' (material) (depth)
3" (size) if telescope see back.

(5) screen 42', 364' (length) (depth to top)

3" perforated (size) (material)

(6) pump AC 80 (HP) (yield gpm)

(7) electric log (yes or no)

(organization running log)

(8) how well bottom plugged orange peel

CODED

DEPT. OF NATURAL RESOURCES
BUREAU OF LAND & WATER RESOURCES


NOV - 1 1982

RECEIVED

DRILLERS REMARKS:

If well telescopes please
sketch and show depths.

GROUND LEVEL

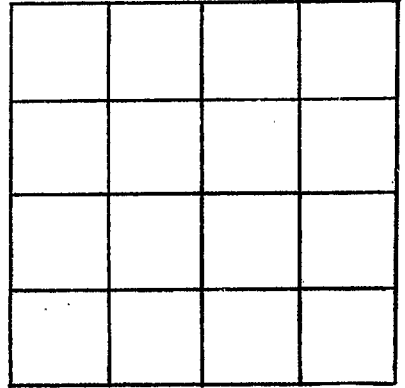

SECTION _____

Please indicate well location X.

ADDITIONAL INFORMATION

If more than one screen,
show locations of each on sketch.