

MISSISSIPPI DEPARTMENT OF NATURAL RESOURCES

Bureau of Land and Water Resources

Southport Mall

P.O. Box 10631

CODED

Jackson, Mississippi 39209

WATER WELL DRILLERS LOG

TOM GRIFFITH

PLUMBING & WELL SERVICE, INC. Walthall

K59
Walthall
11-1-84

11-1-84
date well completed

1320 WILLYSON AVE.
COLUMBIA, MS 39429

county well located

LANDOWNER: Wilson Brothers
Drilling P.O. Drawer 53628
Lafayette, LA 70505
(mailing address)

description of formations encountered	from	to
Gravel	0	210
Chalk	210	248
Sand + P.-Gravel	248	430
No. 1 MORRIS		
1800' N + 502' W		
of SE/4 or of SW 1/4		
CODED		
1-11-85 AKO		

WELL LOCATION:

sec. 2 T. 1 N. R. 12 E
S W
2 miles W of Dexter
(distance) (direction) (nearest town)

WELL PURPOSE: oil loc
(home, irrigation, municipal, industrial)


WELL COMPLETION DATA:

- (1) diameter (inches) 4"
- (2) total depth (feet) 430'
- (3) static water level (feet) 60 below top of ground.
- (4) casing P.C. 390', (material) (depth)
- 7/16" If telescope see back. (size)
- (5) screen 40' 390' (length) (depth to top)
- 1 1/2" 5 lat (size) (material)
- (6) pump 95 (HP) (yield gpm)
- direct (type power)
- (7) electric log no (yes or no)
- nda (organization running log)
- (8) how well bottom plugged welded

DRILLERS REMARKS:

If well telescopes please sketch and show depths.

GROUND LEVEL

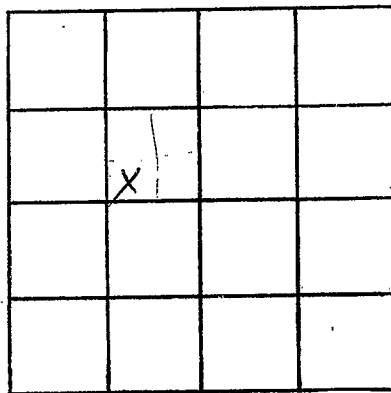

SECTION 2

Please indicate well location X.

ADDITIONAL INFORMATION

If more than one screen, show locations of each on sketch.