

MISSISSIPPI DEPARTMENT OF ENVIRONMENTAL QUALITY

Office of Land and Water Resources

P. O. Box 10631  
Jackson, MS 39289-0631  
WATER WELL DRILLERS LOG

COUNTY WELL LOCATED  
Walworth  
WELL NUMBER K-70 CODED  
DATE WELL COMPLETED  
5/3/04

PERMIT NUMBER  
NAME OF DRILLING FIRM  
Jordan Well Serv

NAME & MAILING ADDRESS OF LANDOWNER  
Ricky Dillon  
1131 Hwy 48  
Tylertown, Ms.  
Latitude:  
Longitude:  
WELL LOCATION. SEC 3 TOWNSHIP 1 RANGE 125  
DISTANCE 1 Miles E of Dexter  
OTHER LANDMARK  
WELL PURPOSE Home Irrigation, Municipal, Industrial, Fish Pond, etc.

PUMP DATA  
PUMP TYPE (Circle One):  
Submersible Turbine, Jet, Flowing Well,  
Other (Describe)  
POWER TYPE (Circle One):  
Electric Tractor, Diesel, Gasoline, Butane,  
Other (Describe) H/P 1 1/2  
DESCRIPTION OF FORMATIONS ENCOUNTERED FROM TO  
Top Soil 0 1  
Sandy Clay 1 75  
SAND 75 120  
**RECEIVED**  
**MAY 14 2004**  
**BY: OLWR**  
Top of Lap Pipe or Reduction in Casing  
FEET IF TELESCOPED OR MORE THAN ONE SCREEN: USE BACK PAGE

WELL DATA  
Well Depth 120 Casing Diameter (In.) 4 Casing Length (Ft.) 110  
Type of Casing PVC Hole Depth 120 Depth to Static Water Level 75  
TYPE OF COMPLETION: (Circle One or More):  
Gravel Packed, Underreamed, Telescoped,  
Natural Development, Open Hole, Other  
(Describe)  
WELL GROUTED TO A DEPTH OF 10 FEET  
Type Grout (circle one): Cement, Bentonite, or Mix

SCREEN DATA  
Diameter - Inches 4 Length - Feet 10 Slot Size - Inches .010  
Screen Type PVC Depth to Bottom - Feet 110

I certify that the well was drilled, constructed and completed in accordance with all applicable Requirements of the Mississippi Department of Environmental Quality and/or the Mississippi Department of Health regulations and state laws.


[Signature] 0-508  
Signature of Licensed Driller and License No.

5/3/04  
Date

Additional Information Required On Back

If well telescopes please sketch and show depths.

GROUND LEVEL

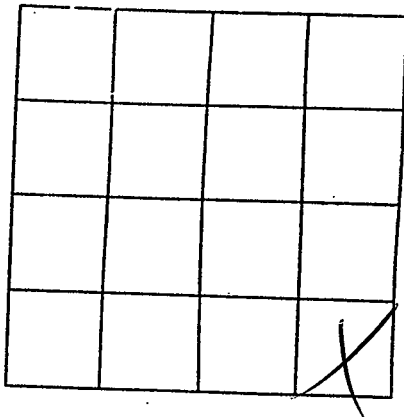

SECTION 3

Please indicate well location X.

Pump Capacity (GPM)	No. of Stages	Setting Depth	FT.
---------------------	---------------	---------------	-----

PUMP TEST

Well yielded \_\_\_\_\_ GPM with  
a drawdown of \_\_\_\_\_ ft.  
after \_\_\_\_\_ hours of pumping

LOG DATA

TYPE OF LOG RUN (Circle One): No Log Run,  
Electric, Gamma Ray, Density, Sonic, Neutron,  
Other (Describe) \_\_\_\_\_

Name of Organization Running Log

GEOLOGIC DATA (Office Use Only)

Surface Elev.	Geologic Unit	Unit Thickness	Depth to Top
Subs. SWL	Date	Analysis	Aquifer Test

Driller's Remarks

If more than one screen,  
show location of each on sketch.