

# State Well Report

## Part 1

Mississippi Department of Environmental Quality  
Office of Land and Water Resources  
P.O. Box 10631  
Jackson, MS 39289-0631  
(601)961-5210  
(601)354-6938 (fax)

County: WAITHALL  
Permit #: \_\_\_\_\_  
Driller: J.C. Sumrall  
Date drilling completed: 9/5/05

For Office Use Only:  
Aquifer: \_\_\_\_\_  
Well #: K-76  
L. S. Elevation: \_\_\_\_\_  
E-log #: \_\_\_\_\_

State Law requires that this report be prepared by the driller in detail and filed with the Department within 30 days of completion of drilling of the well.

Well Owner Information	Well Location
Owner Name: <u>Douglas Magee</u>	Latitude: _____° _____' _____" Longitude: _____° _____' _____"
Mailing Address: _____ <u>209 Herring Rd</u> <u>Sandy Hook, MS</u> City State Zip Code	Method of Lat/Long (circle one): Conventional Survey, USGS quad, Hand-held GPS, Survey-grade GPS _____ 1/4 _____ 1/4 Sec <u>24</u> Twn <u>1N</u> Rng <u>12E</u>
Telephone No. (____) <u>N/A</u>	Distance Direction Nearest Town <u>10</u> Miles <u>ESE</u> of <u>Tyertown</u>

Well Data

Purpose of Well (circle one) Home Industrial Public Supply Irrigation Fish Culture Other: \_\_\_\_\_

Date well drilling started: 9/5/05 Date well drilling completed: 9/5/05

If flowing, method of flow regulation: Valve \_\_\_\_\_ Other (describe) \_\_\_\_\_

Static Water Level: 45 feet above or below (circle one) land surface Date measured: 9/5/05

Method of Measurement (circle one) steel tape electric tape air line other: \_\_\_\_\_

Hole depth: 80 Well depth: 80 Well grouted to a depth of 10 feet

Type of grout (circle one): Cement Bentonite Mix

Casing length: 70 feet Casing diameter: 4 inches Type of casing: PVC

Screen length: 10 feet Screen diameter: 4 inches Type of screen: PVC

Screen slot size: 1.010 inches Setting depth: From 70 feet to 80 feet

Type of completion (circle all applicable): Gravel packed Underreamed Telescoped Open hole Natural Development

Other (describe): \_\_\_\_\_

Top of lap pipe or reduction in casing: \_\_\_\_\_ feet. If telescoped or more than one screen, describe on back of page

Logs run (circle all applicable): No log run Electric Gamma Ray Density Sonic Neutron Other: \_\_\_\_\_

Name of organization running log(s): \_\_\_\_\_

RECEIVED  
SEP 30 2005  
BY: OLWR

I certify that the well was drilled, constructed, and completed in accordance with all applicable requirements of the Mississippi Department of Environmental Quality and/or the Mississippi Department of Health regulations and state laws.

Jordan Well Ser. 0-508  
Print Name of Water Well Contractor and License No.

[Signature]  
Signature of Water Well Contractor

K. 76


If well telescopes please sketch below and show depths.


Ground Level

Description of Formations Encountered	From	To
Top Soil	0	1
Sandy Clay	1	45
Sand	45	80

If more than one screen, show location of each on sketch

Sketch the property layout and include the following: 1) the well location; 2) any permanent structures on the property that may aid in locating the well; 3) any roads, power lines, or other items that may aid in locating the property and the well; 4) indicate direction.

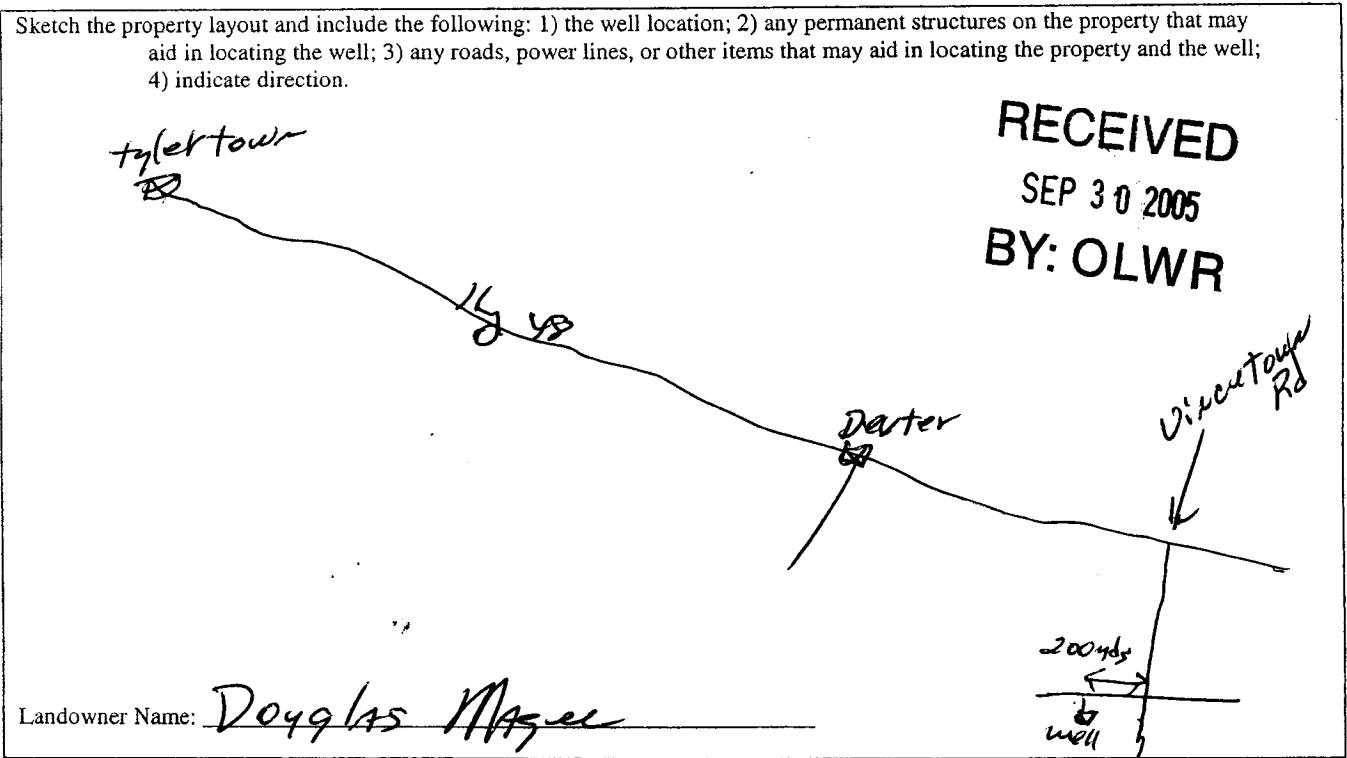

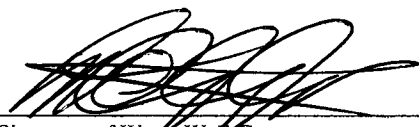  
 \_\_\_\_\_  
 Signature of Water Well Contractor

# STATE WELL REPORT

## Part 2

**Pump Installer's Completion Report**  
Mississippi Department of Environmental Quality  
Office of Land and Water Resources  
P.O. Box 10631  
Jackson, MS 39289-0631  
(601)961-5210  
(601)354-6938 (fax)

For Office Use Only:

County: WAITHAIL  
Permit #: \_\_\_\_\_  
Driller: J.C. Sumrall  
Date completed: 9/5/05

Aquifer: \_\_\_\_\_  
Well #: K-76  
Elevation: \_\_\_\_\_

This report should be prepared by the pump installer in detail and filed with the Department within 30 days of the installation of pump.

Well Owner Information	Well Location
Owner Name: <u>Douglas Magee</u>	Latitude: _____ Longitude: _____
Mailing Address: _____ <u>209 Herring Rd</u> <u>Sandy Hook MS</u> City State Zip Code	Method of Lat/Long (circle one): Conventional Survey, USGS quad, Hand-held GPS, Survey-grade GPS ____ ¼ ____ ¼ Sec <u>24</u> Twn <u>1</u> Rng <u>12</u>
Telephone No. (____) <u>N/A</u>	Distance Direction Nearest Town <u>10</u> Miles <u>ESE</u> of <u>Tylertown</u>

Pump Type Circle one	Power Type Circle one
Air Lift Jet <u>Submersible</u>	Diesel Engine Gasoline Engine Natural Gas
Bucket Piston Turbine	<u>Electric Motor</u> Hand Tractor PTO
Centrifugal Rotary Flowing Well	Windmill Other (specify): _____
Other (specify): _____	Horse Power Rating of Motor: <u>1/2</u>
Date Pump Installed: <u>9/5/05</u>	Setting Depth: <u>75</u>
Rated Pump Capacity: <u>10</u> Gallons Per Minute	Number of Stages: <u>8</u>

**RECEIVED**  
SEP 30 2005  
BY: OLWR

Pump Test Data	Method of Measuring Water Level Circle one
Date Well Tested: <u>9/5/05</u>	Air Line Electric Measuring Line <u>Steel Tape</u>
Static Water Level (A): <u>45</u> Feet Below Land Surface	Other (specify): _____
Pumping Water Level (B): _____ Feet Below Land Surface	For flowing well, measured shut in head: _____ feet
Drawdown [(B) - (A)]: _____ Feet Below Land Surface	Well yielded <u>10</u> GPM with a drawdown of _____ feet after <u>4</u> hours of pumping
Test Pumping Rate: <u>10</u> Gallons Per Minute	
Duration of Pump Test (minimum 4 hours): <u>4</u> hours	

I HEREBY CERTIFY that the above statements are true to the best of my knowledge.

Jordan Well Ser. 0-508 \_\_\_\_\_  
Print Name of Pump Installer and License No. (if applicable) Signature of Pump Installer