

State Well Report

Part 1 - Driller's Log

Mississippi Department of Environmental Quality
Office of Land and Water Resources
P.O. Box 2307
Jackson, MS 39225
(601)961- 5210
(601)961- 5228 (fax)

County: Walthall
Permit #: _____
Driller: Willie Jordan
Date drilling completed: 2/15/13

For Office Use Only:
Aquifer: K 100
Well #: _____
L. S. Elevation: _____
E-log #: _____

State Law requires that this report be prepared by the license holder responsible for the work and filed with the Department at the above address within 30 days of completion of drilling of the well or borehole.

Information on Well Owner
(Landowner if borehole is not for a water well)

Owner Name: Bill Sartin
Mailing Address: 110 Flowers Rd
Tyler town, Ms.
City _____ State _____ Zip Code _____
Telephone No. (____) _____

Well or Borehole Location

Latitude: 31° 03' 36" Longitude: 90° 00' 40"
Method of Lat/Long (circle one): Conventional Survey,
USGS quad, Hand-held GPS, Survey-grade GPS
SW 1/4 SE 1/4 Sec 8 Twn 1N Rng 12E
Distance _____ Direction _____ Nearest Town _____
5 Miles E of Tyler town

Well / Borehole Data

Date drilling started: 2/15/13 Date drilling completed: 2/15/13 Hole depth: 128 Hole diameter: 7 1/2
Location of the source of any surface water used for drilling: POTABLE WATER
Method of dosing and volume of Chlorine used in drilling and development: _____
Logs run (circle all applicable): No log run Electric Gamma Ray Density Sonic Neutron Other: _____
Name of organization running log(s): _____
Purpose of borehole (check one): Water Well Geotechnical/Geological Investigation _____ Ground Source Heat Pump _____
Seismic Survey _____ Other (describe) _____
If drilling is not related to water well construction, skip the remainder of this block

Purpose of Well (check one): Home Industrial _____ Public Supply _____ Irrigation _____ Fish Culture _____ Other: _____
If a flowing well, method of flow regulation: Valve _____ Other (describe) _____
Static Water Level: 85 feet above or below (circle one) land surface Date measured: 2/15/13
Method of Measurement (circle one) steel tape electric tape air line other: _____
Well depth: 128 Well grouted to a depth of 10 feet Type of grout (circle one): Neat Cement Bentonite Mix
Casing length: 118 feet Casing diameter: 4 inches Type of casing: PVC
Screen length: 10 feet Screen diameter: 4 inches Type of screen: PVC
Screen slot size: .010 inches Setting depth: From 118 feet to 128 feet
Type of completion (circle all applicable): Gravel packed Underreamed Telescoped Open hole Natural Development
Other (describe): _____
Top of lap pipe or reduction in casing: _____ feet. *If telescoped or more than 10' screen, describe on next page*

Form: OLWR-SWR-1A (04/08)
RECEIVED
MAR 04 2013
BY: OLWR


K100

The sketch below only required for water wells

Description of formations encountered must be provided for all wells and boreholes unless specifically exempted by regulations

If well telescopes, show depths on sketch


Ground Level →

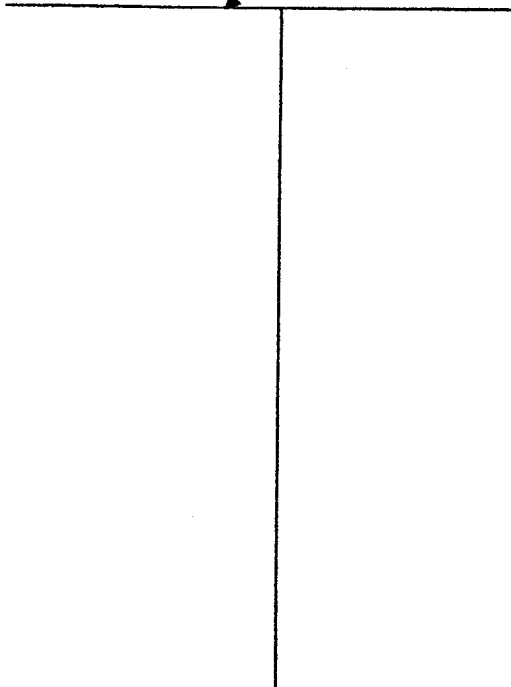

Description of Formations Encountered	From (depth) Ground Level	To (depth)
TOP SOIL	0	1
SANDY CLAY	1	85
SAND	85	128

If more than one screen, show location of each on sketch

Sketch the property layout and include the following: 1) the well location; 2) any permanent structures on the property that may aid in locating the well; 3) any roads, power lines, or other items that may aid in locating the property and the well; 4) a north arrow.

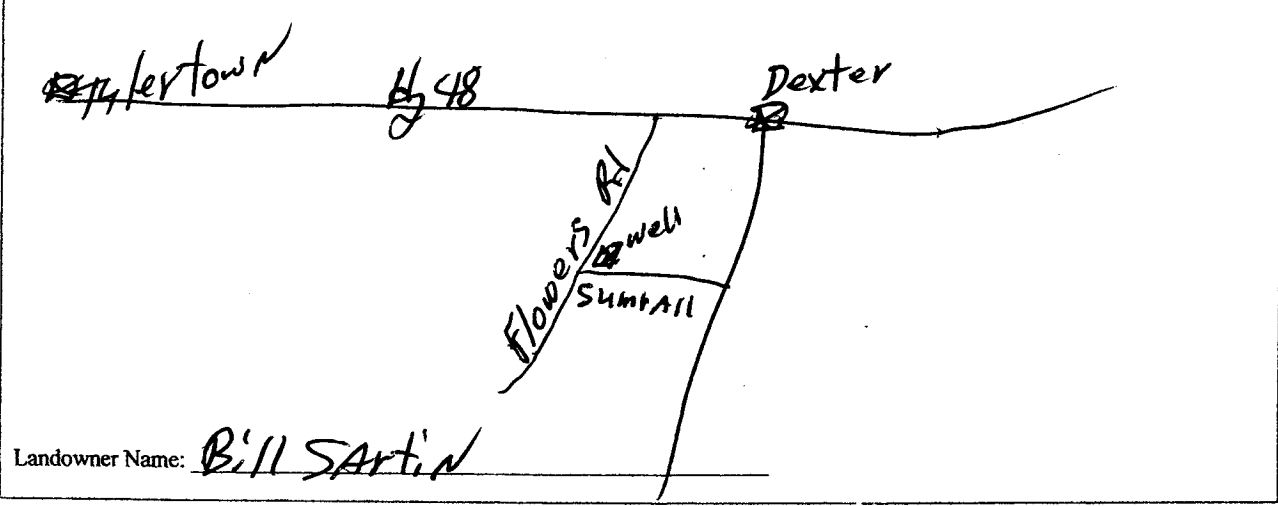

Form: OLWR-SWR-1A (04/08)

I certify that the well/borehole was drilled, constructed, and completed in accordance with all applicable requirements of the Mississippi Department of Environmental Quality and the Mississippi Department of Health regulations, if applicable, and state laws.

Print Name of Responsible Licensee and License No. Date Signature of Licensee **RECEIVED**
MAY 04 2013
BY: OLWR

K100

STATE WELL REPORT

Part 2

Pump Installer's Completion Report
 Mississippi Department of Environmental Quality
 Office of Land and Water Resources
 P.O. Box 2309
 Jackson, MS 39225
 (601)961-5210
 (601)961-5228 (fax)

For Office Use Only:

Aquifer: _____
 Well #: _____
 Elevation: _____

County: WAITHAIL
 Permit #: _____
 Driller: Willie Jordan
 Date completed: 2/15/13
Copy information from block on Part 1

This part of the report must be completed by a licensed water well contractor or a licensed pump installer. A copy of Part 1 of the report must be attached and both parts filed with the Department at the above address within 30 days of well completion.

Well Owner Information	Well Location
Owner Name: <u>Bill Sartin</u>	Latitude: <u>31 03 36</u> Longitude: <u>90 00 40</u>
Mailing Address: <u>110 Flowers Rd</u> <u>Tylertown, Ms.</u>	Method of Lat/Long (check one): Conventional Survey _____ USGS quad _____ Hand-held GPS _____ Survey-grade GPS _____ _____ 1/4 _____ 1/4 Sec <u>8</u> T <u>1N</u> R <u>12E</u>
City _____ State _____ Zip Code _____	Distance _____ Direction _____ Nearest Town _____ <u>5</u> Miles <u>E</u> of <u>Tylertown</u>
Telephone No. (____) _____	

Pump Type Circle one	Power Type Circle one
Air Lift Jet <u>Submersible</u>	Diesel Engine Gasoline Engine Natural Gas
Bucket Piston Turbine	<u>Electric Motor</u> Hand Tractor PTO
Centrifugal Rotary Flowing Well	Windmill Other (specify): _____
Other (specify): _____	Horse Power Rating of Motor: <u>1/2</u>
Date Pump Installed: <u>2/15/13</u>	Setting Depth: <u>100</u> feet
Rated Pump Capacity: <u>10</u> Gallons Per Minute	Number of Stages: <u>8</u>

Pump Test Data	Method of Measuring Water Level Circle one
Date Well Tested: <u>2/15/13</u>	Air Line Electric Measuring Line <u>Steel Tape</u>
Static Water Level (A): <u>85</u> Feet Below Land Surface	Other (specify): _____
Pumping Water Level (B): _____ Feet Below Land Surface	For flowing well, measured shut in head: _____ feet
Drawdown [(B) - (A)]: _____ Feet Below Land Surface	Well yielded <u>10</u> GPM with a drawdown of _____ feet after <u>4</u> hours of pumping
Test Pumping Rate: <u>10</u> Gallons Per Minute	
Duration of Pump Test (minimum 4 hours): <u>4</u> hours	

I HEREBY CERTIFY that the above statements are true to the best of my knowledge.

Willie Jordan 0-508
 Print Name of Pump Installer and License No. (if applicable)

[Signature]
 Signature of Pump Installer

RECEIVED

Form: OLWR-SWR-1B (04/08)

MAR 04 2013

OLWR