

WALTRALL

MISSISSIPPI BOARD OF WATER COMMISSIONERS



K 2002

1-7-65

WATER WELL DRILLERS LOG

Date: 1-7, 1965, Driller: S. S. Rouse County Walthale (Name)

(1) Owner of Land: Jerry D. Herring (Name)

Tylertown Miss. (Address)

(2) Location: 1/4, 1/4, Sec. 2 1-12 T R

8 miles S.E. of Tylertown (distance) (direction) (Nearest Town)

(3) Topography: Hilly (Hilly) (Flat) (Level)

(4) Purpose of Well: Domestic (Domestic Irrigation) (Municipal, Industrial, Other)

Description & Color of Materials Sand, Clay, Red Clay, Shell, etc. Thickness Feet Depth Feet

30 feet Red clay

40 feet sand

20 feet water sand

Information upon completion of well:

(1) Diameter 2 inches.

(2) Total Depth 90 feet.

(3) Water Level 70 feet below top of ground.

(4) Cased to 84, Size 2

(5) Screen: Size 2, Length 5 feet


(6) Were any formations sealed against pollution?

yes, X no.

If YES depth of formation

Why

Drillers Remarks:

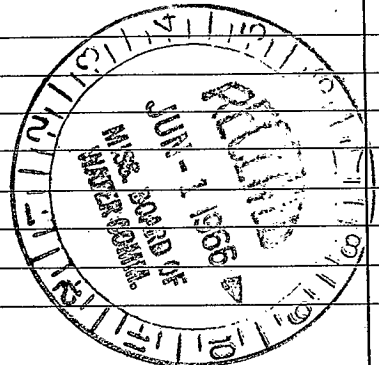

(Use Back Side)

Well No.

