

Walthall  
K 2003  
9/75

MISSISSIPPI  
BOARD OF WATER COMMISSIONERS  
416 North State Street  
Jackson, Mississippi 39201

WATER WELL DRILLERS LOG

Sept. 1975 E. B. Sherrard Walthall  
date well completed firm name county well located

LANDOWNER:  
Nervia Allen  
Rt. 7 - Sylbertown, Ms.  
(mailing address)

description of formations encountered	from	to
RED LOOSE SANDY CLAY	0	110
SAND & GRAVEL	110	142'

WELL LOCATION:  
sec 26 T 1 N R 12 E 130  
S W  
12 miles SE of Sylbertown  
(distance) (direction) (nearest town)

WELL PURPOSE:  
(home, irrigation, municipal, industrial)  
home


- WELL COMPLETION DATA:
- (1) diameter (inches) 2"
  - (2) total depth (feet) 142'
  - (3) static water level (feet) 110' <sup>below</sup> <sub>above</sub> top of ground.
  - (4) casing pl 137'  
(material) (depth)
  - 2"  
(size) If telescope see back.
  - (5) screen 5'  
(length) (depth to top)
  - 2" pl  
(size) (material)
  - (6) pump 1 1/2 7  
(HP) (yield gpm)
  - E  
(type power)
  - (7) electric log (yes or no) no
  - (organization running log)
  - (8) how well bottom plugged BWW

DRILLERS REMARKS:

RECEIVED  
DEC - 5 1975  
MISS. BD. OF WATER COMMISSIONERS

If well telescopes please sketch and show depths.

GROUND LEVEL

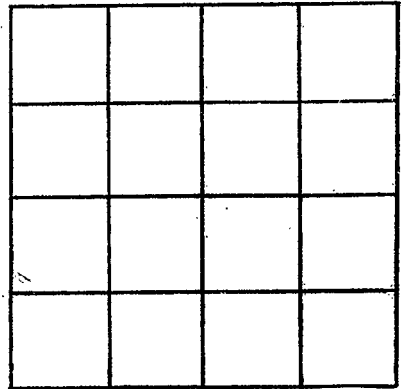

SECTION \_\_\_\_\_

Please indicate well location X.

ADDITIONAL INFORMATION

If more than one screen,  
show locations of each on sketch.