

WALTHALL
R 2004
11-27-75

MISSISSIPPI
 BOARD OF WATER COMMISSIONERS
 416 North State Street
 Jackson, Mississippi 39201

WATER WELL DRILLERS LOG

Nov 27
 date well completed

137 75 Pieves Well Ser
 firm name

Walthall
 county well located

LANDOWNER:	description of formations encountered	from	to
<u>Jessie Rayford</u> <u>Lyletown</u> (mailing address)	<u>clay</u>	<u>0</u>	<u>20</u>
WELL LOCATION: sec. <u>18</u> T. <u>21</u> N R. <u>12</u> E <u>6</u> miles <u>ESE</u> of <u>Lyletown</u> (distance) (direction) (nearest town)	<u>red sand</u>	<u>20</u>	<u>70</u>
WELL PURPOSE: <u>shop</u> (home, irrigation, municipal, industrial)	<u>hard sand</u>	<u>70</u>	<u>70</u>
WELL COMPLETION DATA:	<u>labbly</u>	<u>90</u>	<u>114</u>
(1) diameter (inches) <u>4"</u>	<u>gravel sand</u>	<u>118</u>	<u>150</u>
(2) total depth (feet) <u>130</u>			
(3) static water level (feet) <u>75</u> below top of ground.			
(4) casing <u>plastic battons</u> (material) (depth)			
_____ (size) If telescope see back.			
(5) screen <u>6"</u> <u>124</u> (length) (depth to top)			
_____ (size) _____ (material)			
(6) pump <u>1/2</u> <u>10</u> (HP) (yield gpm)			
_____ (type power)			
(7) electric log <u>no</u> (yes or no)			
_____ (organization running log)			
(8) how well bottom plugged _____			


DRILLERS REMARKS: _____			

RECEIVED
 JAN 28 1976

MISS. Bd. OF WATER COMM

If well telescopes please sketch and show depths.

GROUND LEVEL

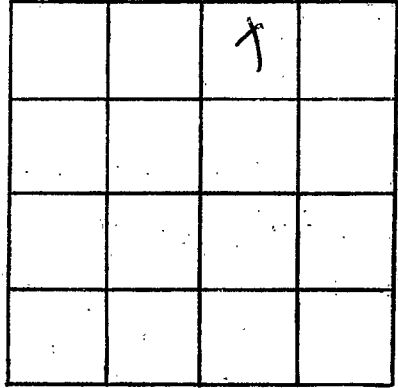

SECTION 18

Please indicate well location X.

ADDITIONAL INFORMATION

If more than one screen,
show locations of each on sketch.