

WALTHALL

R 2005

1-22-76

MISSISSIPPI BOARD OF WATER COMMISSIONERS
416 North State Street
Jackson, Mississippi 39201

WATER WELL DRILLERS LOG

Jan 22
date well completed

13V 76 Stafford Water Well Dr. Co.
firm name

WALTHALL
county well located

LANDOWNER: Phillip Branch

description of formations encountered	from	to
top soil	0	3
clay	3	40
chalk	40	130
sand	130	160
sand & gravel	160	185

(mailing address)

WELL LOCATION:

sec. 3 T 1 N R 18 W

10 miles west of Sandy Hook
(distance) (direction) (nearest town)

WELL PURPOSE:
(home, irrigation, municipal, industrial)

WELL COMPLETION DATA:


- (1) diameter (inches) 4"
- (2) total depth (feet) 185
- (3) static water level (feet) _____ below above top of ground.
- (4) casing plastic, 172' (material) (depth)
4" (size) If telescope see back.
- (5) screen 194' 172' (length) (depth to top)
4" (size) plastic (material)
- (6) pump 1 (HP) 15 (yield gpm)
- (7) electric log Yes

(organization running log)

(8) how well bottom plugged B.W.

DRILLERS REMARKS:


John Ray Dyer

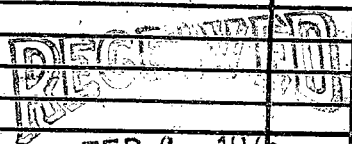

MISS. BD. OF WATER COMM

If well telescopes please sketch and show depths.

GROUND LEVEL

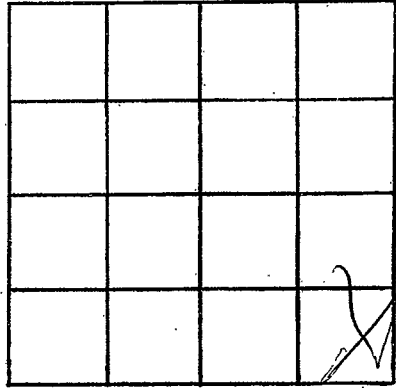

SECTION _____

Please indicate well location X.

ADDITIONAL INFORMATION

If more than one screen,
show locations of each on sketch.