

WALTHALL

K2007

3-15-76

MISSISSIPPI BOARD OF WATER COMMISSIONERS
416 North State Street
Jackson, Mississippi 39201

WATER WELL DRILLERS LOG

3-15

1976 B. Woodward Drilling

WATHALL

date well completed

firm name

county well located

LANDOWNER: S. H. SANDIFER

Tylertown, Miss.

(mailing address)

WELL LOCATION:

sec. 5 T. 1 N R. 12 E
1 miles WNW of DEXTER
(distance) (direction) (nearest town)

WELL PURPOSE: Home
(home, irrigation, municipal, industrial)

WELL COMPLETION DATA:


- (1) diameter (inches) 4
- (2) total depth (feet) 130
- (3) static water level (feet) 82' below top of ground.
- (4) casing PVC 120'
(material) (depth)
4" (size) if telescope see back.
- (5) screen 10' 120'
(length) (depth to top)
4" x .015 PVC
(size) (material)
- (6) pump 1 8
(HP) (yield gpm)
115V AC
(type power)
- (7) electric log NO.
(yes or no)

(organization running log)

(8) how well bottom plugged float
Type BWV

DRILLERS REMARKS:

description of formations encountered	from	to
Red clay	0	16'
Red sand	16	55'
Purple clay	55	61'
Gravel	61	96'
Purple clay	96	115'
Red sand	115	130'

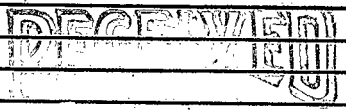


MAR 18 1976

MISS. BD. OF WATER COMM.

If well telescopes please sketch and show depths.

GROUND LEVEL

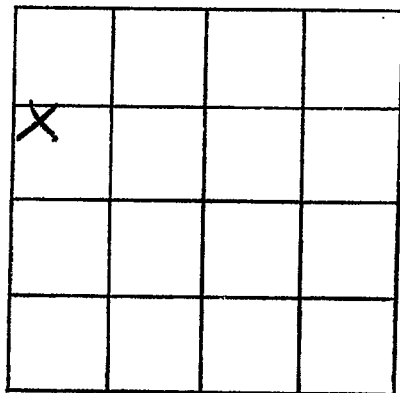

SECTION 5

Please indicate well location X.

ADDITIONAL INFORMATION

If more than one screen,
show locations of each on sketch.