

WALTHALL  
 K 2008  
 3-22-78

MISSISSIPPI  
 BOARD OF WATER COMMISSIONERS  
 416 North State Street  
 Jackson, Mississippi 39201

WATER WELL DRILLERS LOG

3-22-78 date well completed  
 Firm name  
 county well located

LANDOWNER:  
 Otis Stringer  
 R.R. Tylertown  
 (mailing address)

description of formations encountered	from	to
Red clay	0	20
Red sand	20	80
Red gravel	80	100
Coarse sand & gravel	100	112

WELL LOCATION:  
 sec. 7 T 1 N R 12 E  
 S W  
 6 miles SE of Tylertown  
 (distance) (direction) (nearest town)

WELL PURPOSE: Home  
 (home, irrigation, municipal, industrial)


- WELL COMPLETION DATA:
- (1) diameter (inches) 4
  - (2) total depth (feet) 112
  - (3) static water level (feet) 75 below top of ground.
  - (4) casing PVC, 104, (material) (depth)  
 4 (size) if telescope see back.
  - (5) screen 8, 104 (length) (depth to top)  
 4, PVC (size) (material)
  - (6) pump 1/2, 10 (HP) (yield gpm)  
 Elec (type power)
  - (7) electric log no (yes or no)
  - (8) how well bottom plugged Sand block

DRILLERS REMARKS:

RECEIVED  
 APR 27 1978

If well telescopes please sketch and show depths.

GROUND LEVEL

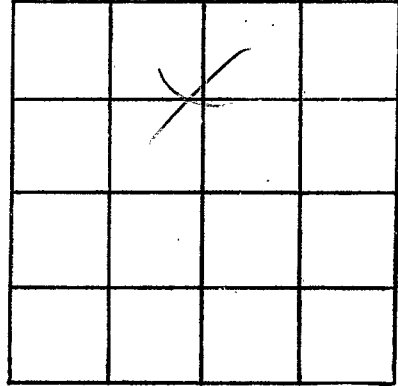

SECTION 7

Please indicate well location X.

ADDITIONAL INFORMATION

If more than one screen,  
show locations of each on sketch.