

WALTHALL

MISSISSIPPI BOARD OF WATER COMMISSIONERS  
416 North State Street  
Jackson, Mississippi 39201

WATER WELL DRILLERS LOG

4-18-1978  
date well completed

Red Martin Water Well Walthall  
firm name county well located

LANDOWNER:

Mr. C. Branch

description of formations encountered

from

to

Gayles Farm, Miss.  
RT-7 (mailing address)

Top clay 0 28  
Dry sand 29 80  
Gravel 80 85  
Firm sand 85 145  
Hard & Brittle 145 180

WELL LOCATION:

sec 26 T 1 N R 12 E  
S SE W  
4 1/2 miles (distance) of Denton, Miss (nearest town)

WELL PURPOSE:

(home, irrigation, municipal, industrial)


WELL COMPLETION DATA:

- (1) diameter (inches) 14"
- (2) total depth (feet) 180'
- (3) static water level (feet) 98' below top of ground
- (4) casing PVC (material), 170' (depth)
- (5) screen 10' (length), 170' (depth to top)
- (6) pump 1/2 (HP), 8 (yield gpm)
- (7) electric log no (yes or no)

(organization running log)

(8) how well bottom plugged?  
2' sand & shell - Beach


DRILLERS REMARKS:

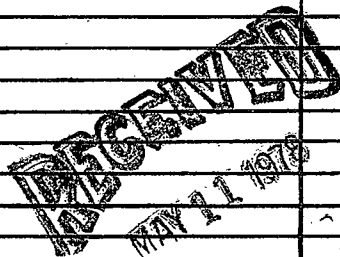

COMM

If well telescopes please sketch and show depths.

GROUND LEVEL

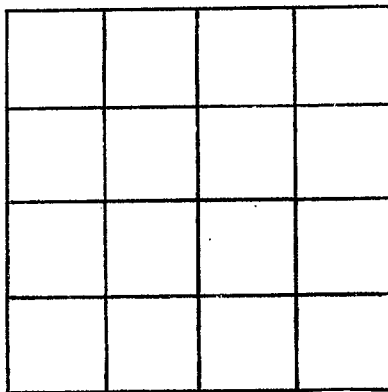

SECTION \_\_\_\_\_

Please indicate well location X.

ADDITIONAL INFORMATION

If more than one screen, show locations of each on sketch.