

WALTHALL

K 200

5-15-78

MISSISSIPPI BOARD OF WATER COMMISSIONERS 416 North State Street Jackson, Mississippi 39201

WATER WELL DRILLERS LOG

May 15 1978 Rivers Well Dr. Walthall date well completed firm name county well located

Table with columns: LANDOWNER, WELL LOCATION, WELL PURPOSE, WELL COMPLETION DATA, description of formations encountered, from, to. Includes handwritten entries for owner (William McKenzie), location (T1N R12E), purpose (home), and formation details (Clay, Red sand, etc.).


RECEIVED

AUG 28 1978

MISS. BD. OF WATER COMM

If well telescopes please sketch and show depths.

GROUND LEVEL

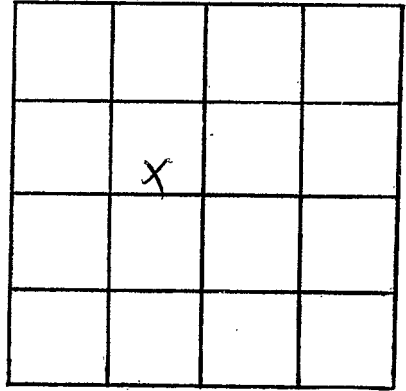

SECTION 18

Please indicate well location X.

ADDITIONAL INFORMATION

If more than one screen,  
show locations of each on sketch.